


Claim of Beneficial Use - Place of Use Map Transfer T-9825 (Permit S-18957)

Water Right in the name of: City of Creswell
Township 19 South, Range 3 West (W.M.)

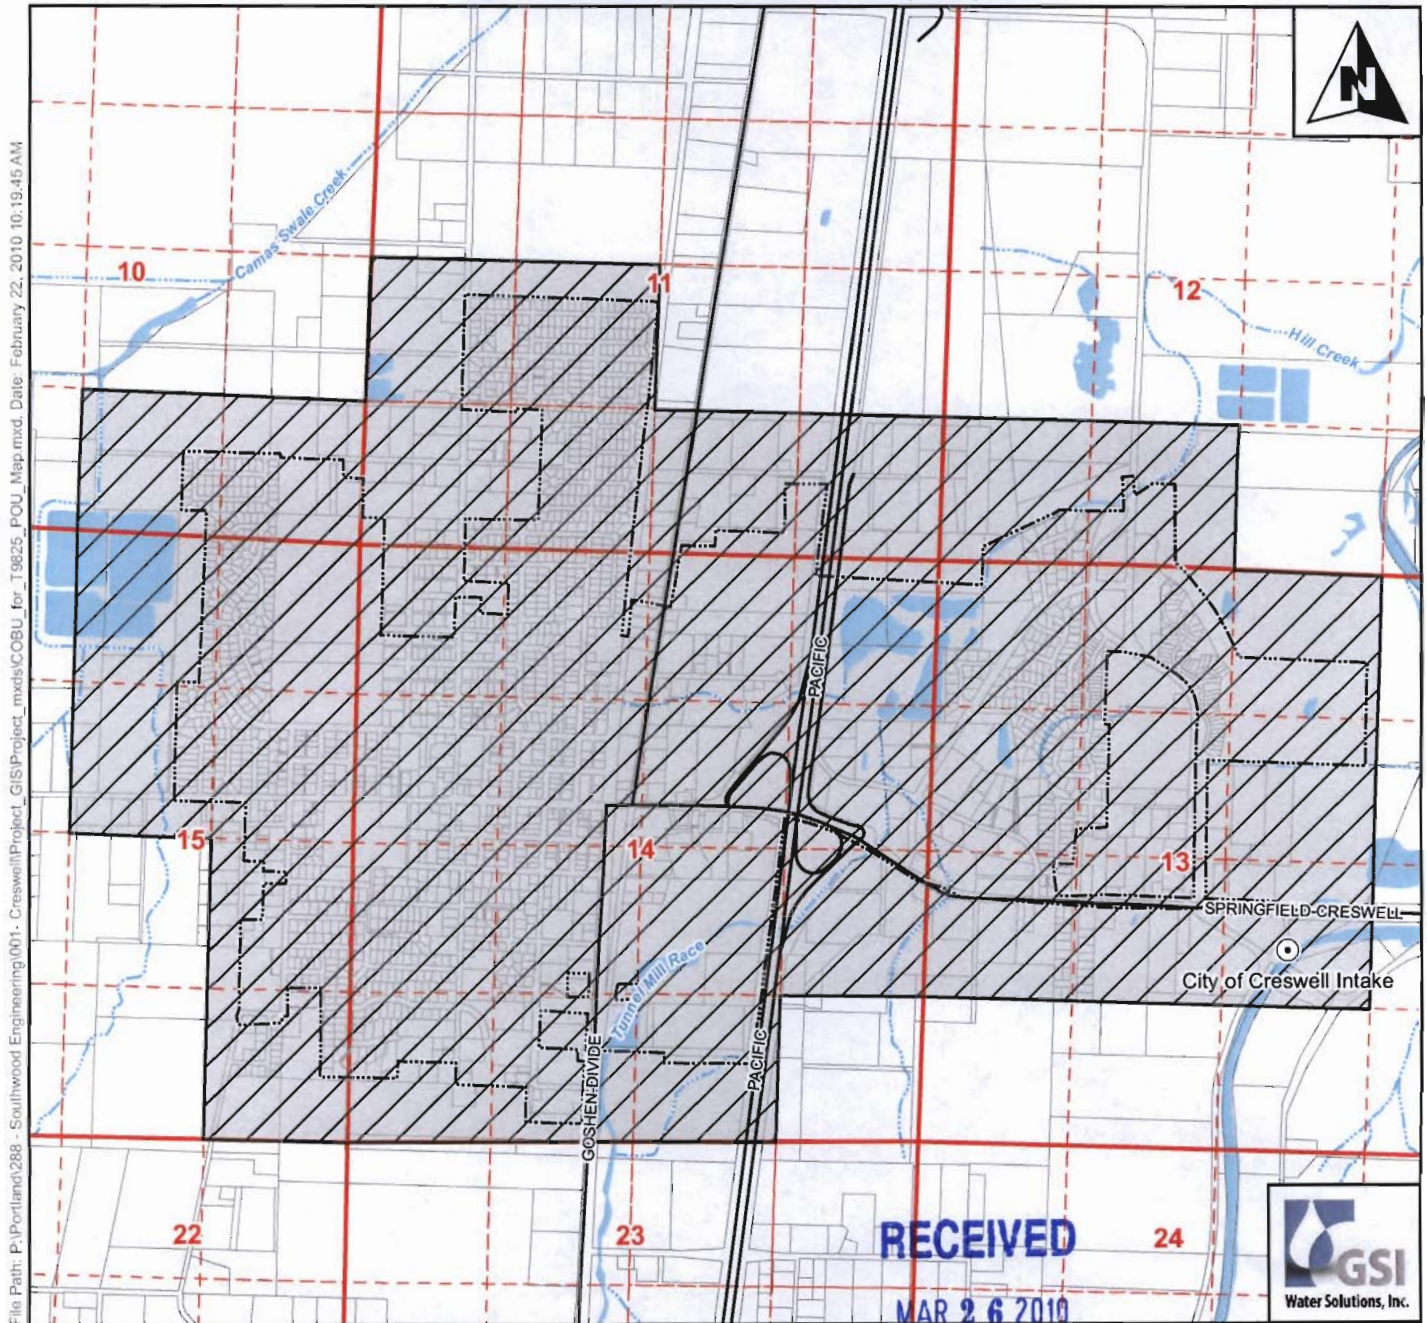

Legend

- ⊙ Point of Diversion (POD)
- ▨ Place of Use (POU)
- ⊕ Creswell City Limits
- ⊕ Taxlots
- Streets
- Waterbodies
- Watercourses

POD Legal Description

City of Creswell Intake
Located 800 feet South and 2100 feet West from the E 1/4 corner of Section 13, Township 19 South, Range 3 West (W.M.)

Scale

1 inch = 1,760 feet
0 660 1,320 2,640
Feet

Note

This map was prepared for the purpose of identifying the location of a water right only and it is not intended to provide legal dimensions or location of property ownership lines.

Map Information

Map Date: February 22, 2010
Prepared By: GSI Water Solutions, Inc.

WATER RESOURCES DEPT
SALEM, OREGON




EXPIRES: 12-31-2010

CWRE stamp and signature

Claim of Beneficial Use - Point of Diversion Map

Transfer T-9825 (Permit S-18957)

Water Right in the name of: City of Creswell
Township 19 South, Range 2 & 3 West (W.M.)

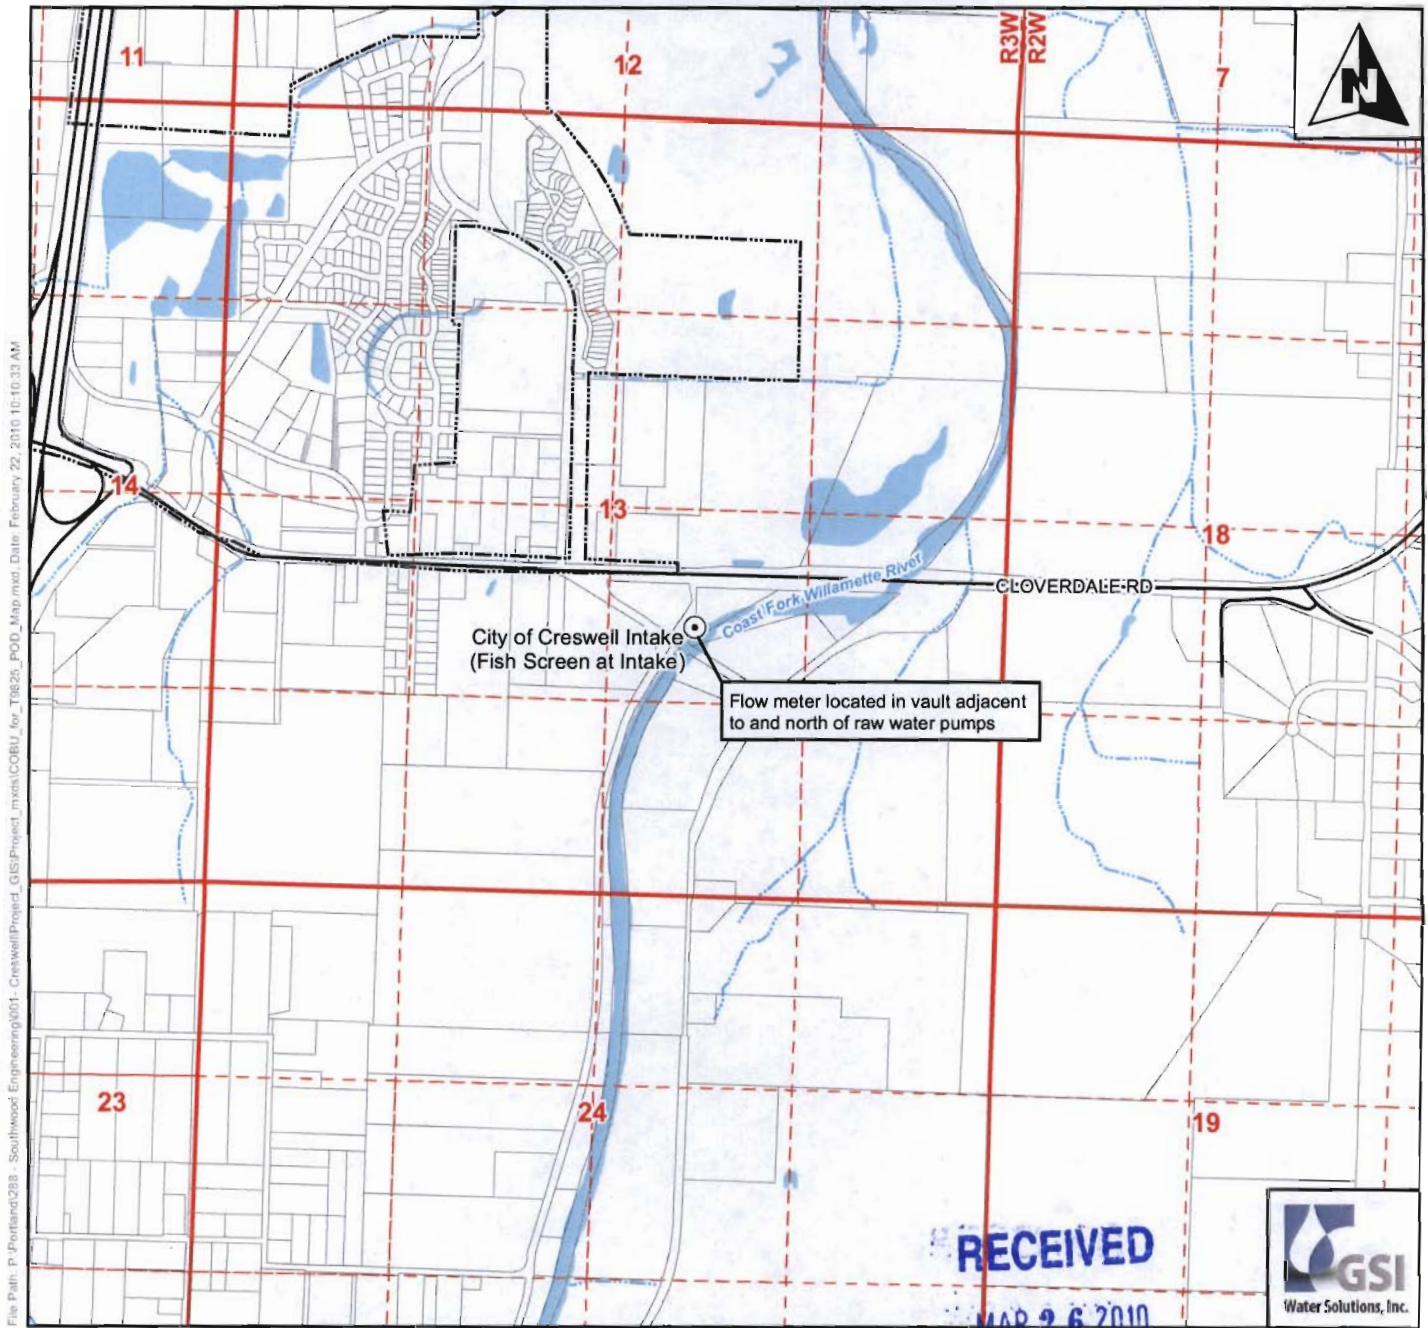

Legend

- City of Creswell Intake
- Creswell City Limits
- Taxlots
- Streets
- Waterbodies
- Watercourses

POD Legal Description

City of Creswell Intake

Located 800 feet South and 2100 feet West from the E 1/4 corner of Section 13, Township 19 South, Range 3 West (W.M.)

Scale

1 inch = 1,320 feet

0 330 660 1,320

Feet

Note

This map was prepared for the purpose of identifying the location of a water right only and it is not intended to provide legal dimensions or location of property ownership lines.

Map Information

Map Date: February 22, 2010

Prepared By: GSI Water Solutions, Inc.

WATER RESOURCES DEPT
SALEM, OREGON



EXPIRES: 12-31-2010

CWRE stamp and signature