


T.6 N. R.35E. W. M.

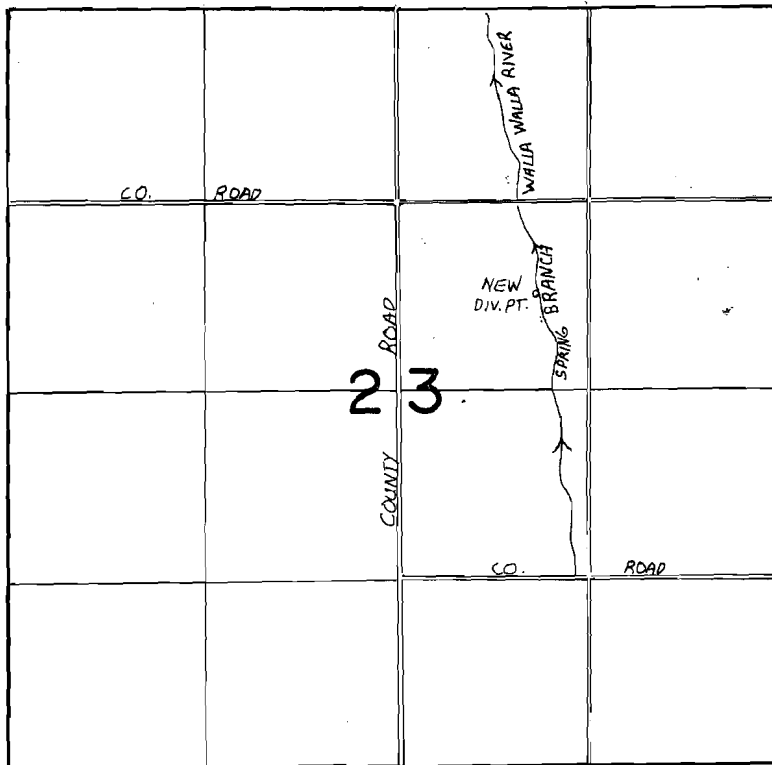

SCALE 1"=1320'



DIV. PT. LOCATED 660' N. AND 950' E. FROM CENTER 1/4 COR. SEC.23

FINAL PROOF SURVEY

UNDER

TRANSFER 5041
IN NAME OF

.....EARL L. BROWN.....

Surveyed *NOV. 19...* 19*84*., by *V.L. CHURCH*.....