


# T. 38 S., R. 1 E., W. M.

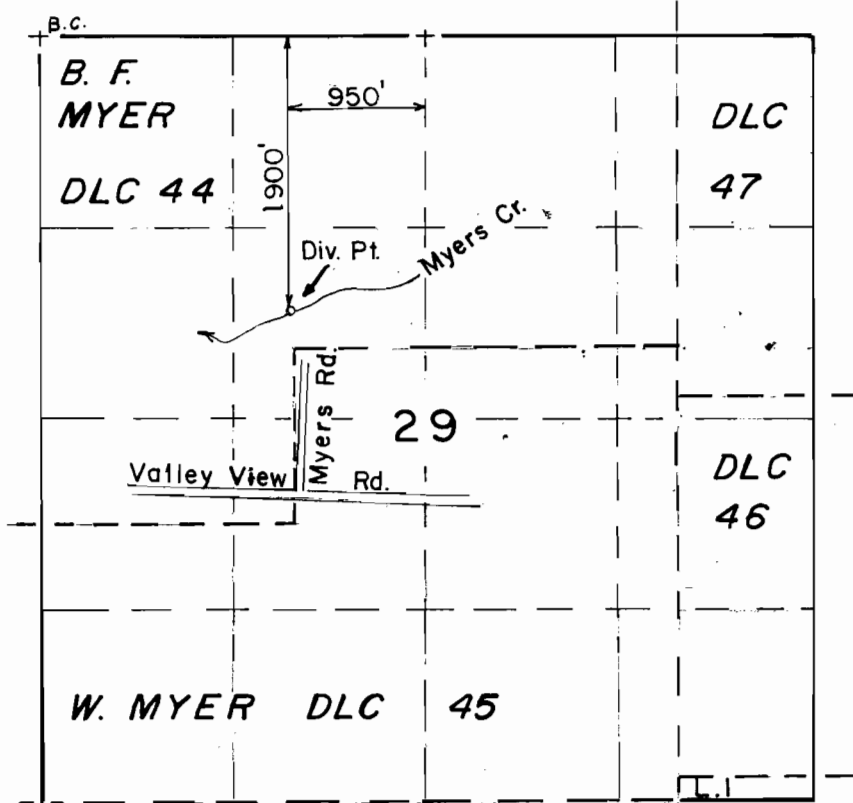

Scale: 1" = 1320'

## FINAL PROOF SURVEY UNDER

TRANSFER NO. 5754

Application No. .... Permit No. ....  
IN NAME OF

..... JOHN D. FOSTER .....

Surveyed NOV. 1. 1990., by B.S. JAMES.....