


Claim of Beneficial Use Map

Permit R-14492 (Application R-86688)
Township 6 North, Range 5 West (W.M.)

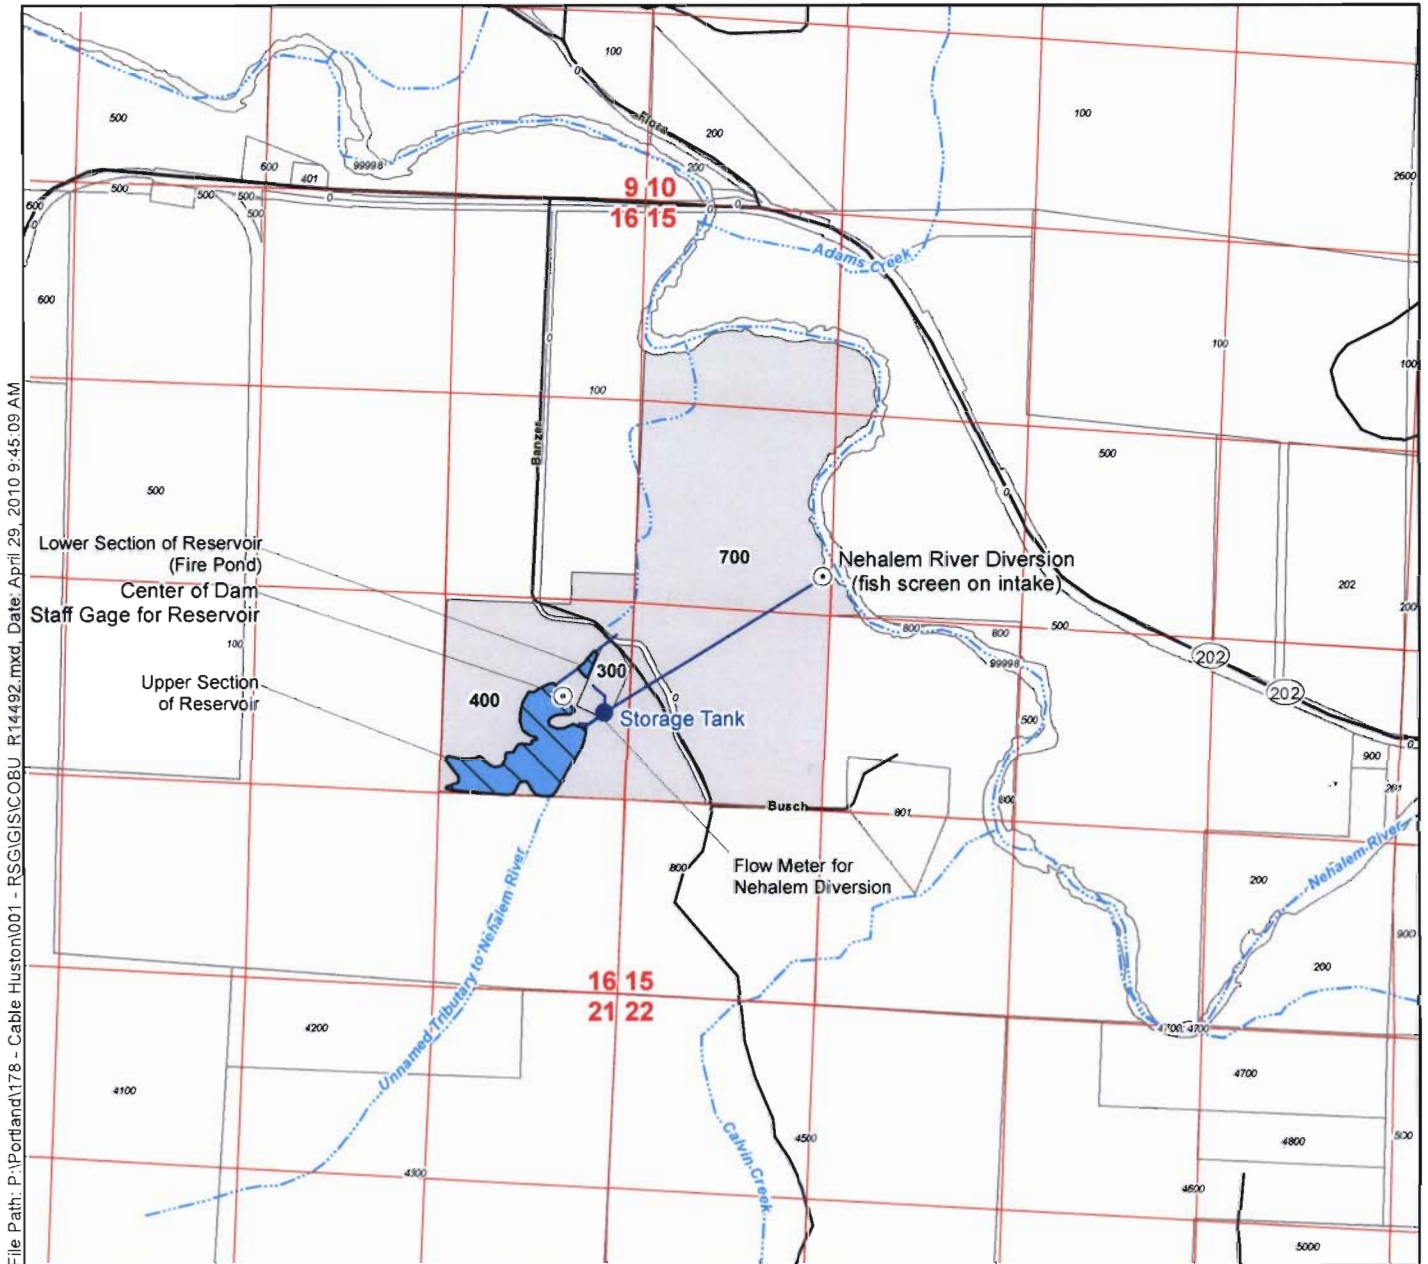

File Path: P:\Portland\178 - Cable Huston\001 - RSG\GIS\COBU_R14492.mxd, Date: April 29, 2010 9:45:09 AM

Legend

- Point of Diversion (POD)
- Place of Use (POU)
- Reservoir (Permit R-14492)
- Water Supply Mainlines
- ⊕ Taxlots Owned by RSG Forest Products/Olympic Forest Products
- ⊕ Taxlots
- Streets
- ~ Rivers


POD Location Description

Nehalem River Diversion Located 2,860 feet North and 1,375 feet East from the SW corner of Section 15, Township 6 North, Range 5 West (W.M.)
Center of Dam Located 2,050 feet North and 440 feet West from the SE corner of Section 16, Township 6 North, Range 5 West (W.M.)

RECEIVED

MAY 03 2010

WATER RESOURCES DEPT
SALEM, OREGON

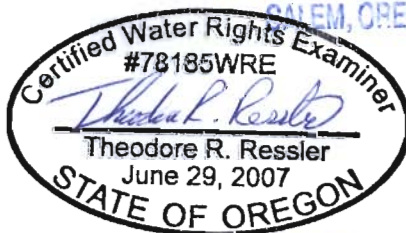

EXPIRES: 12-31-2010



Map Information
 Projection: Oregon Lambert Conformal Conic
 Datum: North American Datum of 1983
 Date: April 29, 2010
 Prepared By: GSI Water Solutions, Inc.

Data Sources
 Spatial data sets obtained from RSG Forest Products, Oregon Geospatial Enterprise Office, Columbia County Department of Land Development Services, and BLM.

Disclaimer
 This map was prepared for the purpose of identifying the location of a water right only and it is not intended to provide legal dimensions or location of property ownership lines.

Scale
 0 660 1,320
 1 inch equals 1,320 feet

