

RECEIVED

APR 26 2010


Claim of Beneficial Use Map

Permit R-13942 (Application R-69772)

Township 3 South, Range 6 West (W.M.)

WATER RESOURCES DEPT

SALEM, OREGON

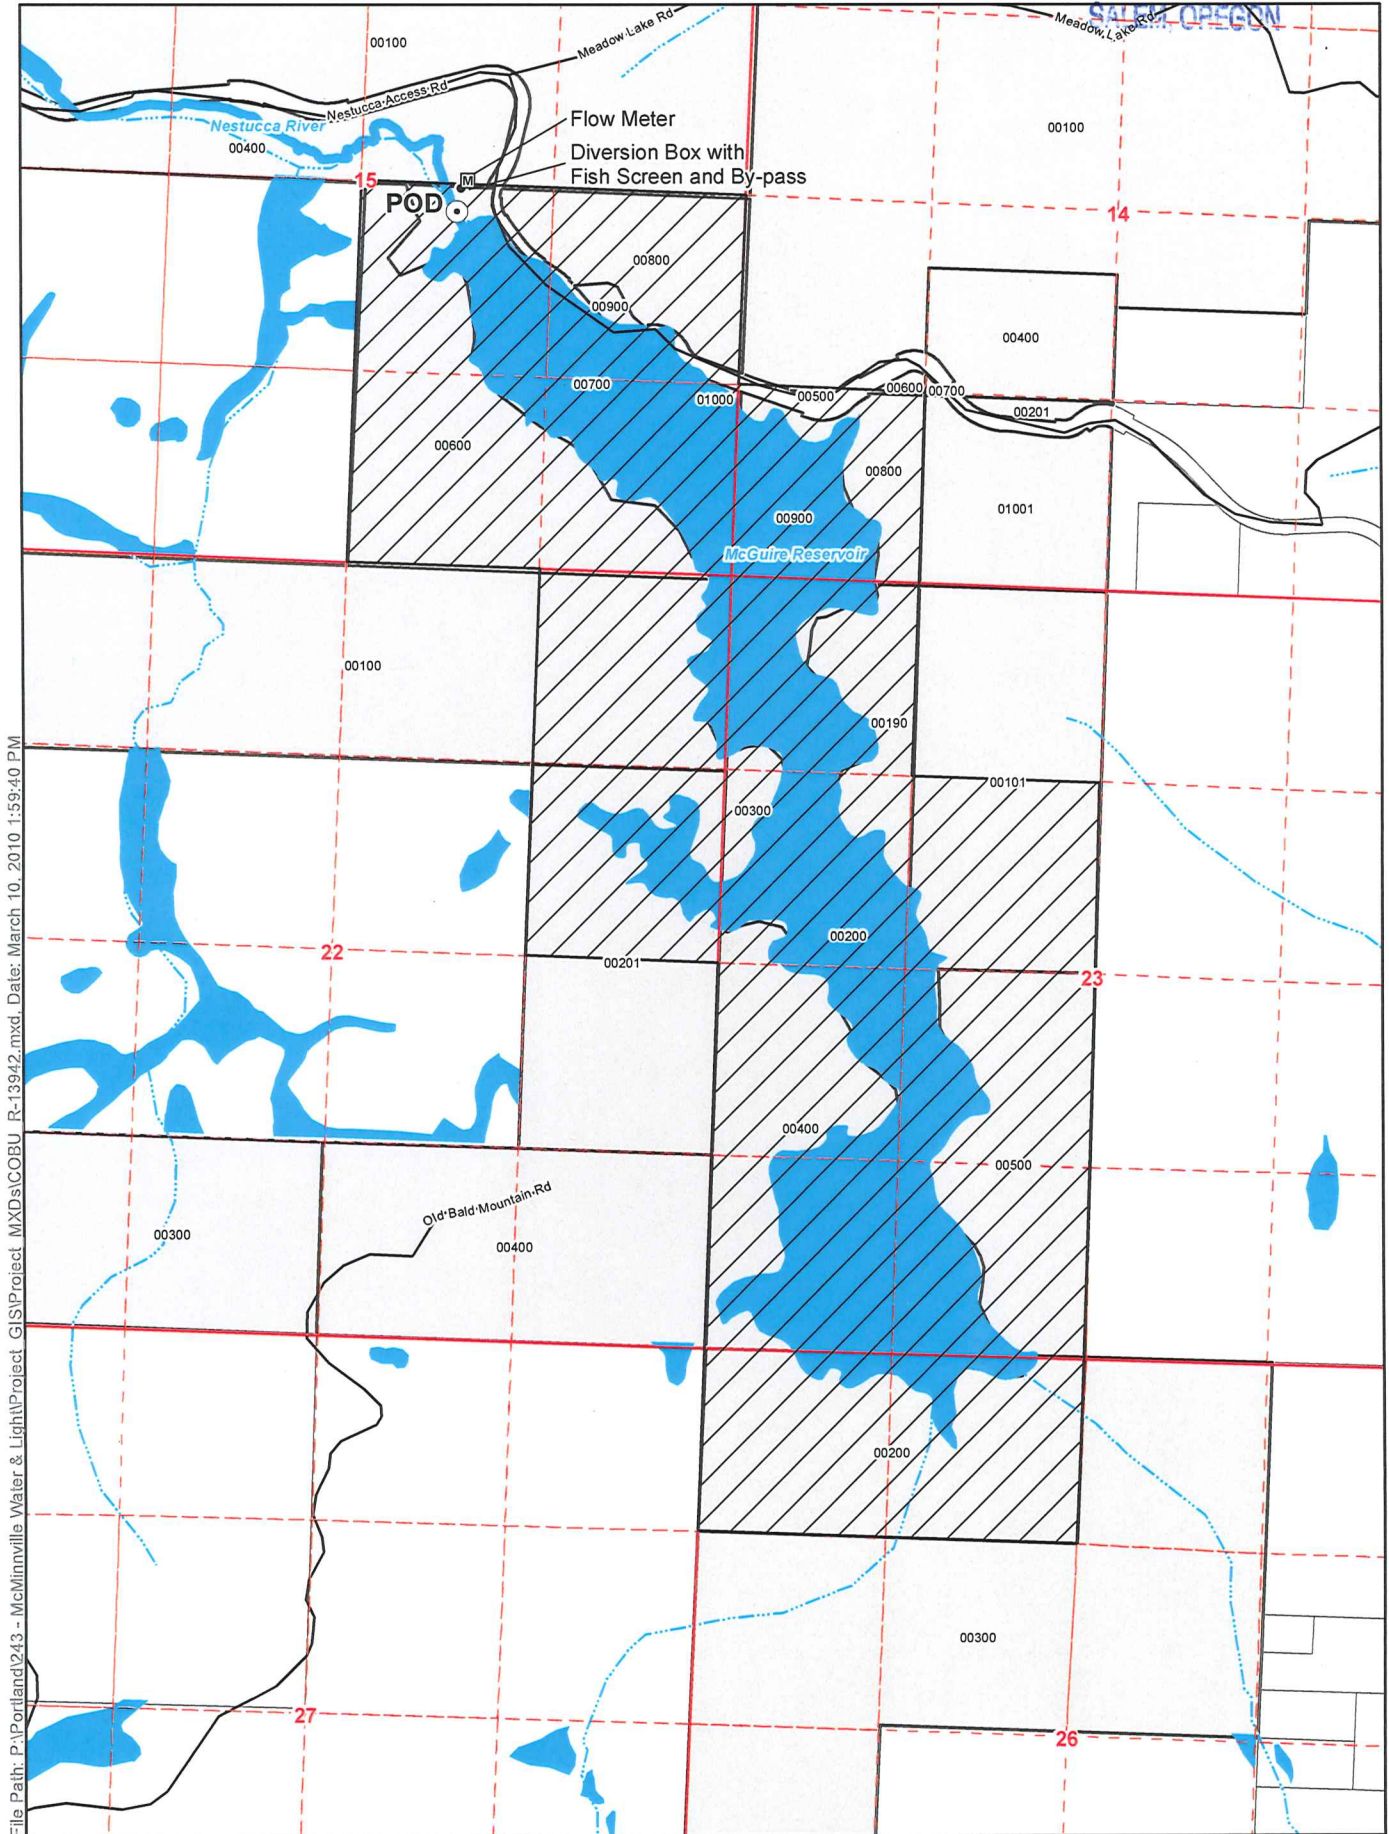


File Path: P:\Portland\243 - McMinnville Water & Light\Project GIS\Project MXDs\COBU_R-13942.mxd, Date: March 10, 2010 1:59:40 PM

Legend

- Point of Diversion (POD)
- ▨ Place of Use (POU)
- ⊕ Taxlots
- ⊕ Taxlots Owned by Permittee
- Streets
- ~ Watercourses
- Waterbodies

POD Location Description

POD - Center of Dam
 Located 2,445 feet North and 1,970 feet West
 from the SE corner of Section 15, Township 3
 South, Range 6 West (W.M.)

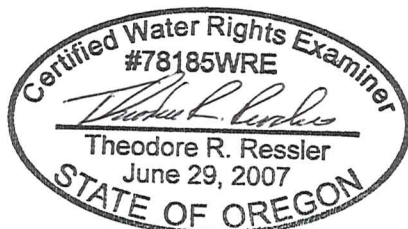

EXPIRES: 12-31-2010

Map Information

Projection: Oregon State Plane North
 Datum: North American Datum of 1983
 Date: March 10, 2010
 Prepared By: GSI Water Solutions, Inc.

Data Sources

ESRI, OWRD

Disclaimer

This map was prepared for the purpose of identifying the location of a water right only and it is not intended to provide legal dimensions or location of property ownership lines.



Scale

0 660 1,320
 1 inch equals 1,320 feet

