


**FINAL PROOF MAP
CLAIM OF BENEFICIAL USE**

APPLICATION NO. G-13722

PERMIT NO. G-12533

CLIENT: DON JONES

LOCATED IN SECTION 15 AND 16
TOWNSHIP 2 SOUTH, RANGE 4 EAST, W.M.
CLACKAMAS COUNTY, OREGON
SCALE: 1" = 400' SEPTEMBER 22, 2004

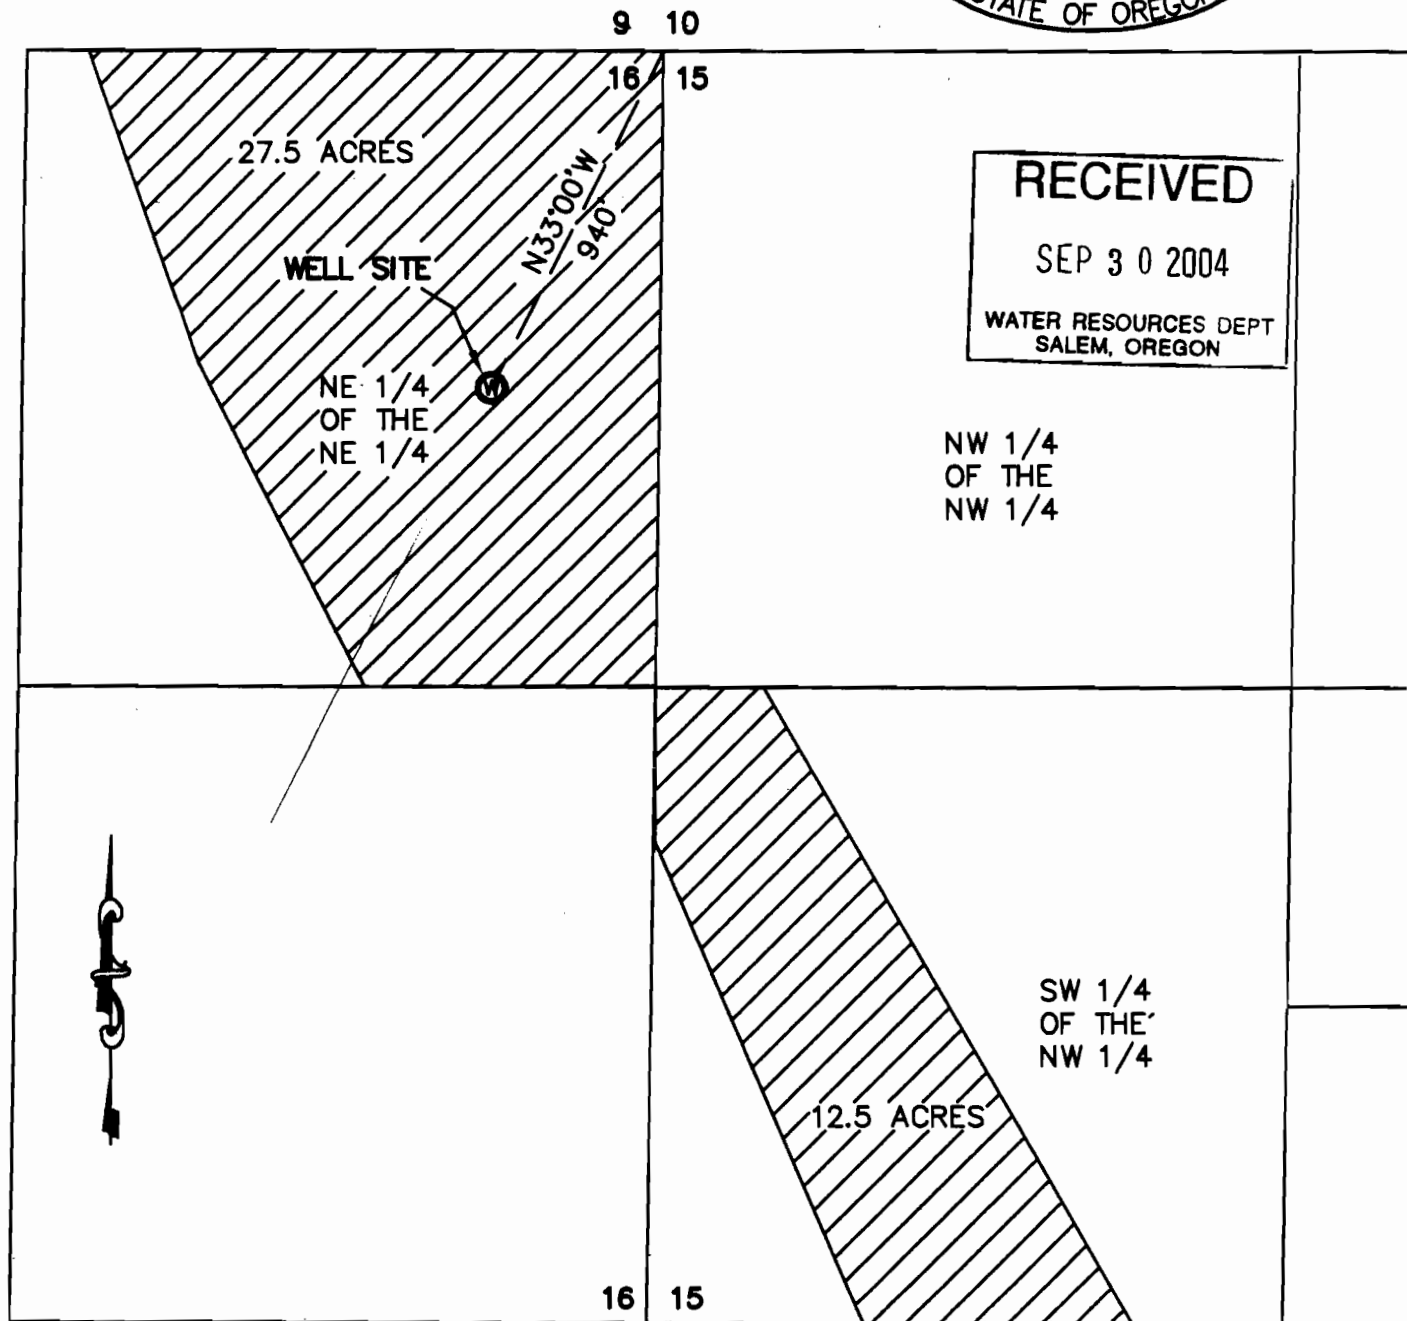

THIS DRAWING IS NOT A LAND SURVEY. PROPERTY LINES
AND/OR OTHER LINES OF OCCUPATION SHOWN HEREON
ARE NOT REPRESENTED BY THE UNDERSIGNED TO MEET
ACCURACY STANDARDS OF LAND SURVEYS.



all COUNTY SURVEYORS
& PLANNERS, INC.
P.O. BOX 955
SANDY, OREGON 97055
(503) 668-3151
JOB# 04-213