


T. 38 S., R. 4 W., W.M.

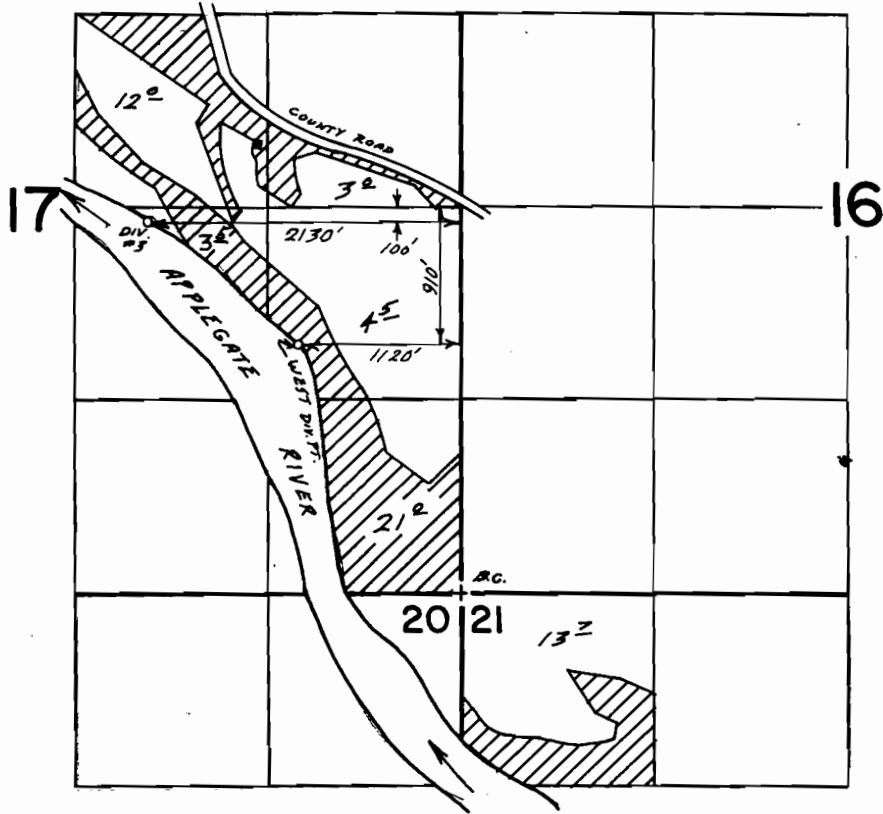

Scale 1" = 1320'

FINAL PROOF SURVEY UNDER

Application No. 57.997. Permit No. 437.86....
IN NAME OF

.....
Surveyed July 28, 1983, by B.S. James.....