


T. 5 S. R. 6 W.W.M.

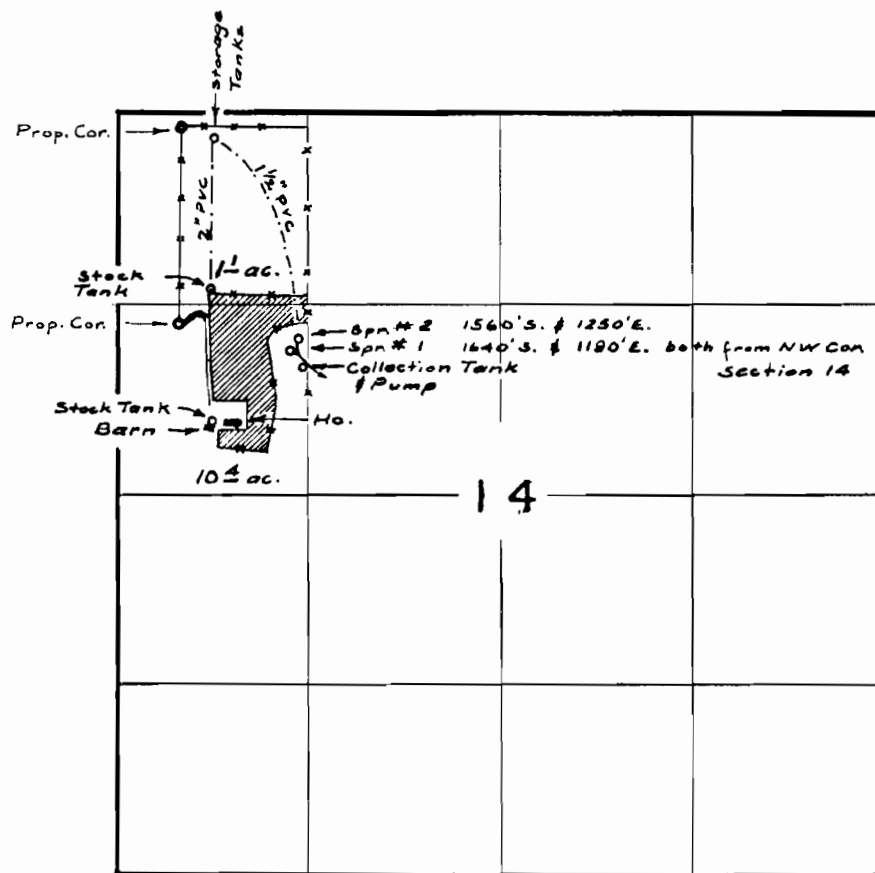

Scale 1" = 1320'

# FINAL PROOF SURVEY

Applic. No. 69737 Permit No. 51077

In Name Of

MELVA J. and DONALD O. CALDWELL, SR.

THE PREPARATION OF THIS MAP IS FOR THE  
PURPOSE OF IDENTIFYING THE LOCATION  
OF THE WATER RIGHT ONLY AND HAS NO  
INTENT TO PROVIDE DIMENSIONS OR LOCATION  
OF PROPERTY OWNERSHIP LINES.

