


RECEIVED

T.4N., R.10W., W.M.
SECTION 7

DEC 31 1998
WATER RESOURCES DEPT.
SALEM, OREGON

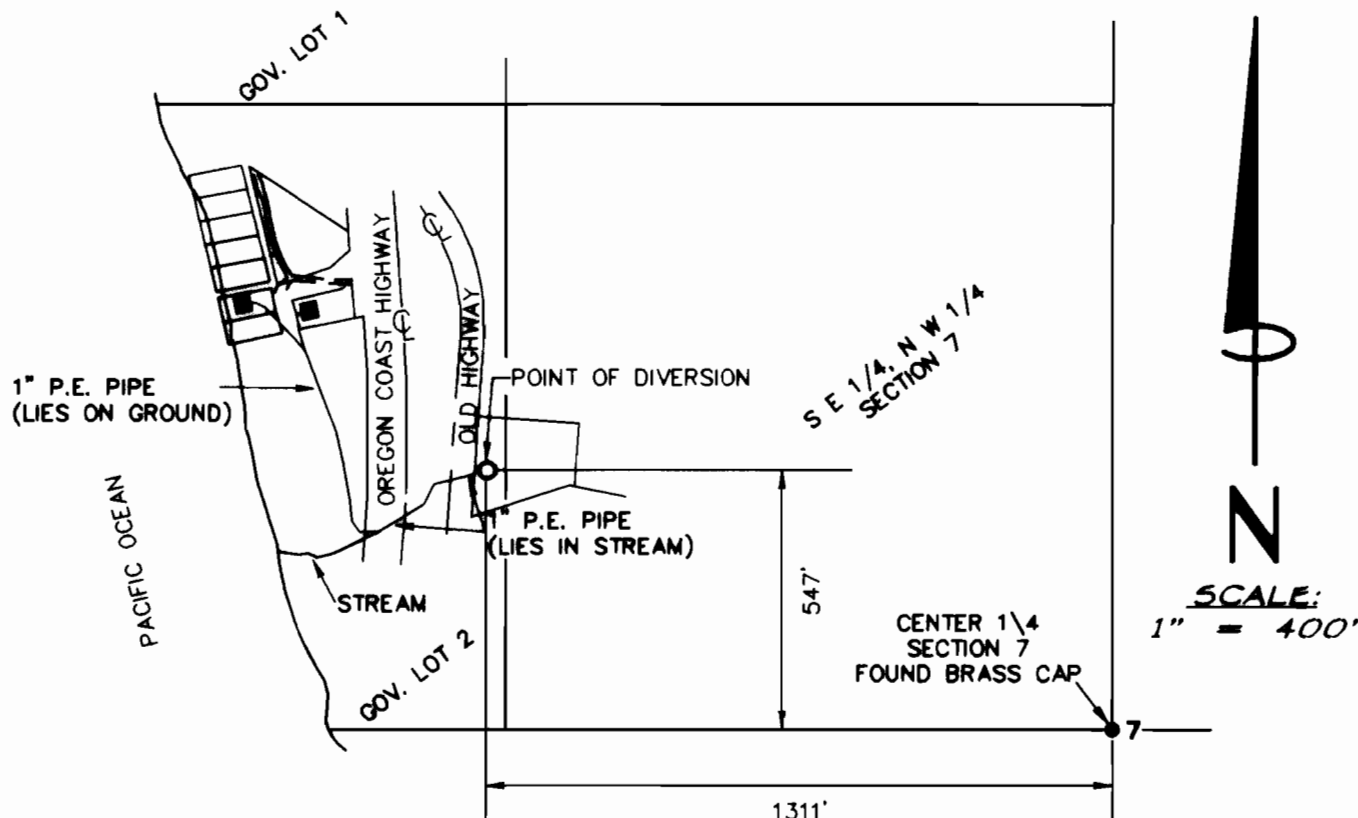

FINAL PROOF SURVEY

UNDER


APPLICATION NO. 80530, PERMIT NO. 53244

IN THE NAME OF

PAM PATRIE, FRANK ENGEL,
RICHARD WOODCOCK AND ANA MUNOZ

SURVEYED OCT. 13, 1998

FILE: 32820001.DWG

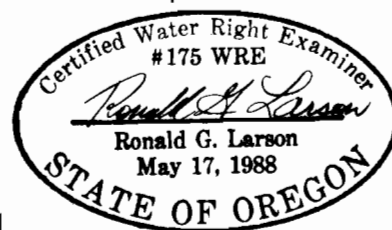

HLB & ASSOCIATES, INC.
SURVEYING • ENGINEERING • PLANNING

160 LANEDA AVE.
MANZANITA, OR 97130
(503) 368-5394
FAX: (503) 368-5847

4253A HWY 101 N.
GEARHART, OR 97138
(503) 738-3425
FAX: (503) 738-7455