MAY 1 6 1995

WA.
SALEM, OREGO

LAKE SIMTUSTUS

NORMAL RESERVOIR ELEVATION 1578 FEET

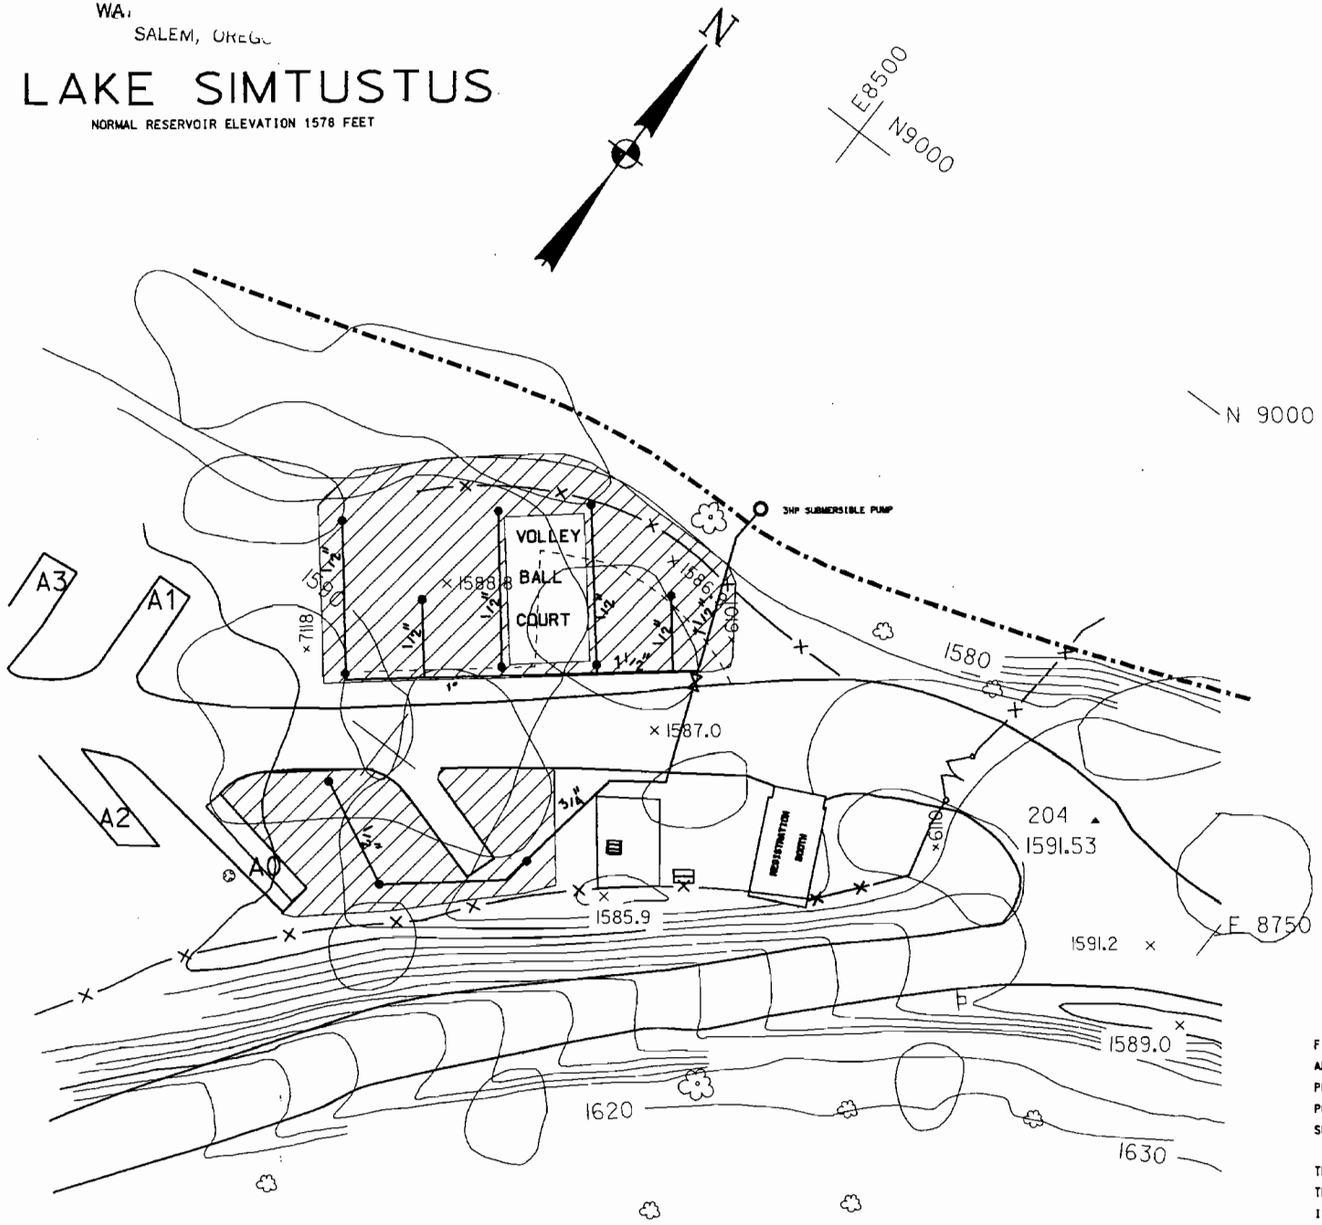

PLAN VIEW

SCALE: 1" = 40' APPROX.

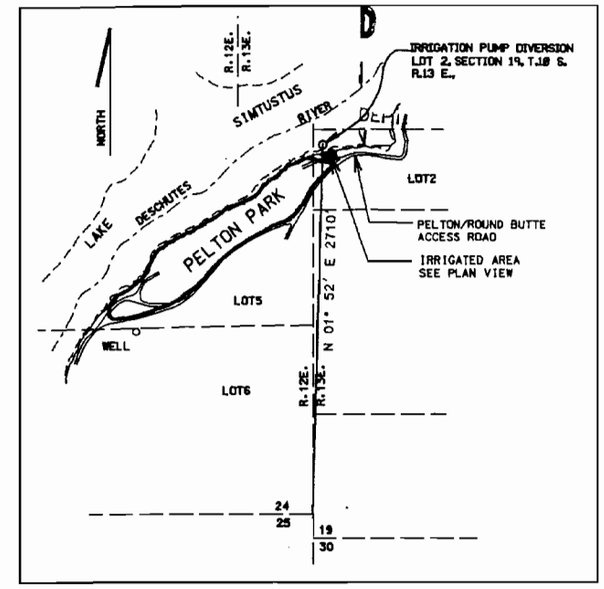

LOCATION MAP

1 IN. =1000FT APPROX.

LEGEND

- ● SPRINKER PROPOSED LOCATION
- IRRIGATION AREA

Certified Water Right Examiner
158
Harold J. Csergei
Harold J. Csergei
May 17, 1988
STATE OF OREGON

FINAL PROOF SURVEY UNDER
APPLICATION NO.71695
PERMIT NO. 51403 IN THE NAME OF
PORTLAND GENERAL ELECTRIC CO.
SURVEYED APRIL 20, 1995

THE PURPOSE OF THIS MAP IS TO IDENTIFY
THE LOCATION OF THE WATER RIGHT.
IT IS NOT INTENDED TO PROVIDE INFORMATION
RELATIVE TO THE LOCATION OF PROPERTY
OWNERSHIP BOUNDARY LINES.

REV	DATE	DESCRIPTION	BY	CHK	SUPV	ENGR	APPD
●	5/2/95	MAP INFORMATION SHOWN FOR WATER RIGHTS PURPOSES.	JAV	JAV			

REVISIONS

PORTLAND GENERAL ELECTRIC
PORTLAND, OREGON

PELTON PROJECT
PELTON PARK
IRRIGATION WATER SYSTEM
WATER RIGHTS FINAL PROOF MAP

APPROVALS			
DESIGNER	JAV	SCALE	1" = 20'
DESIGN ENGR	HJC	DRAWN BY	JAV
DESIGN SUPV		CHECKED BY	
BRANCH MANAGER		DATE	MAY 8, 1995
DEPARTMENT MANAGER		DRAWING NUMBER	E8938
JOB NUMBER		REV	0

1/1

\e6658\civ\water.map May. 11, 1995 15:02:44