
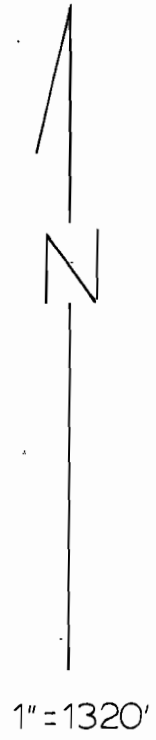


RECEIVED

SEP - 4 1997

WATER RESOURCES DEPT.  
SALFORD DIVISION

# T. 5 N., R. 36 E., W.M.

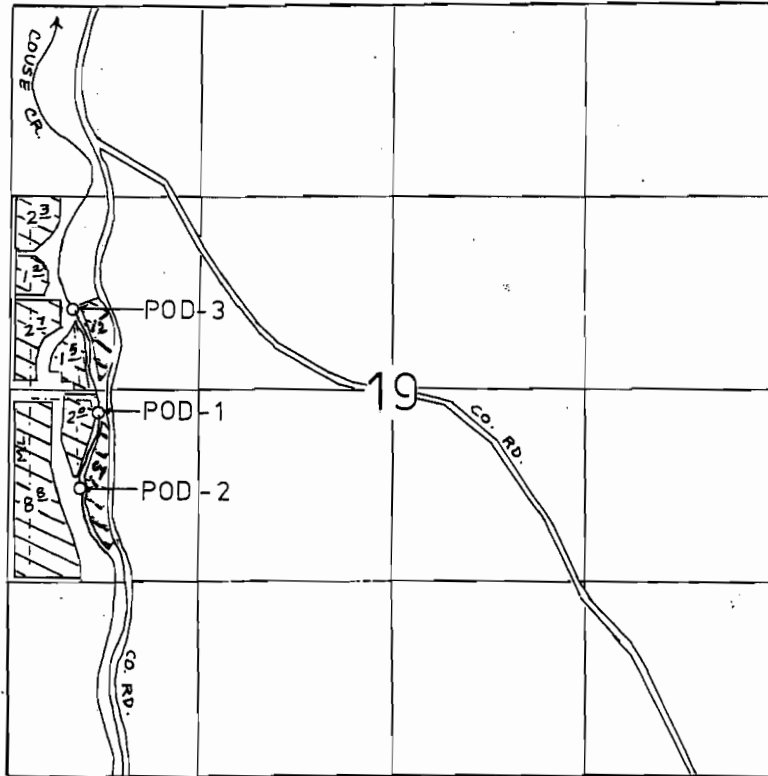

POD 1 - 150' S. & 610' E.  
 POD 2 - 660' S. & 500' E. ALL FROM THE W 1/4 COR. SEC. 19  
 POD 3 - 550' N. & 430' E.

## FINAL PROOF SURVEY

UNDER

Application No. 69183 Permit No. 50170  
 IN NAME OF

MICHAEL B. BANKS AND MARIANNE ALDERSON

Surveyed April 29, 1994, by J. Miller

5/12/06 JWG