


.....
COUNTY

Scale 1 = 400

34 S 5 W 17

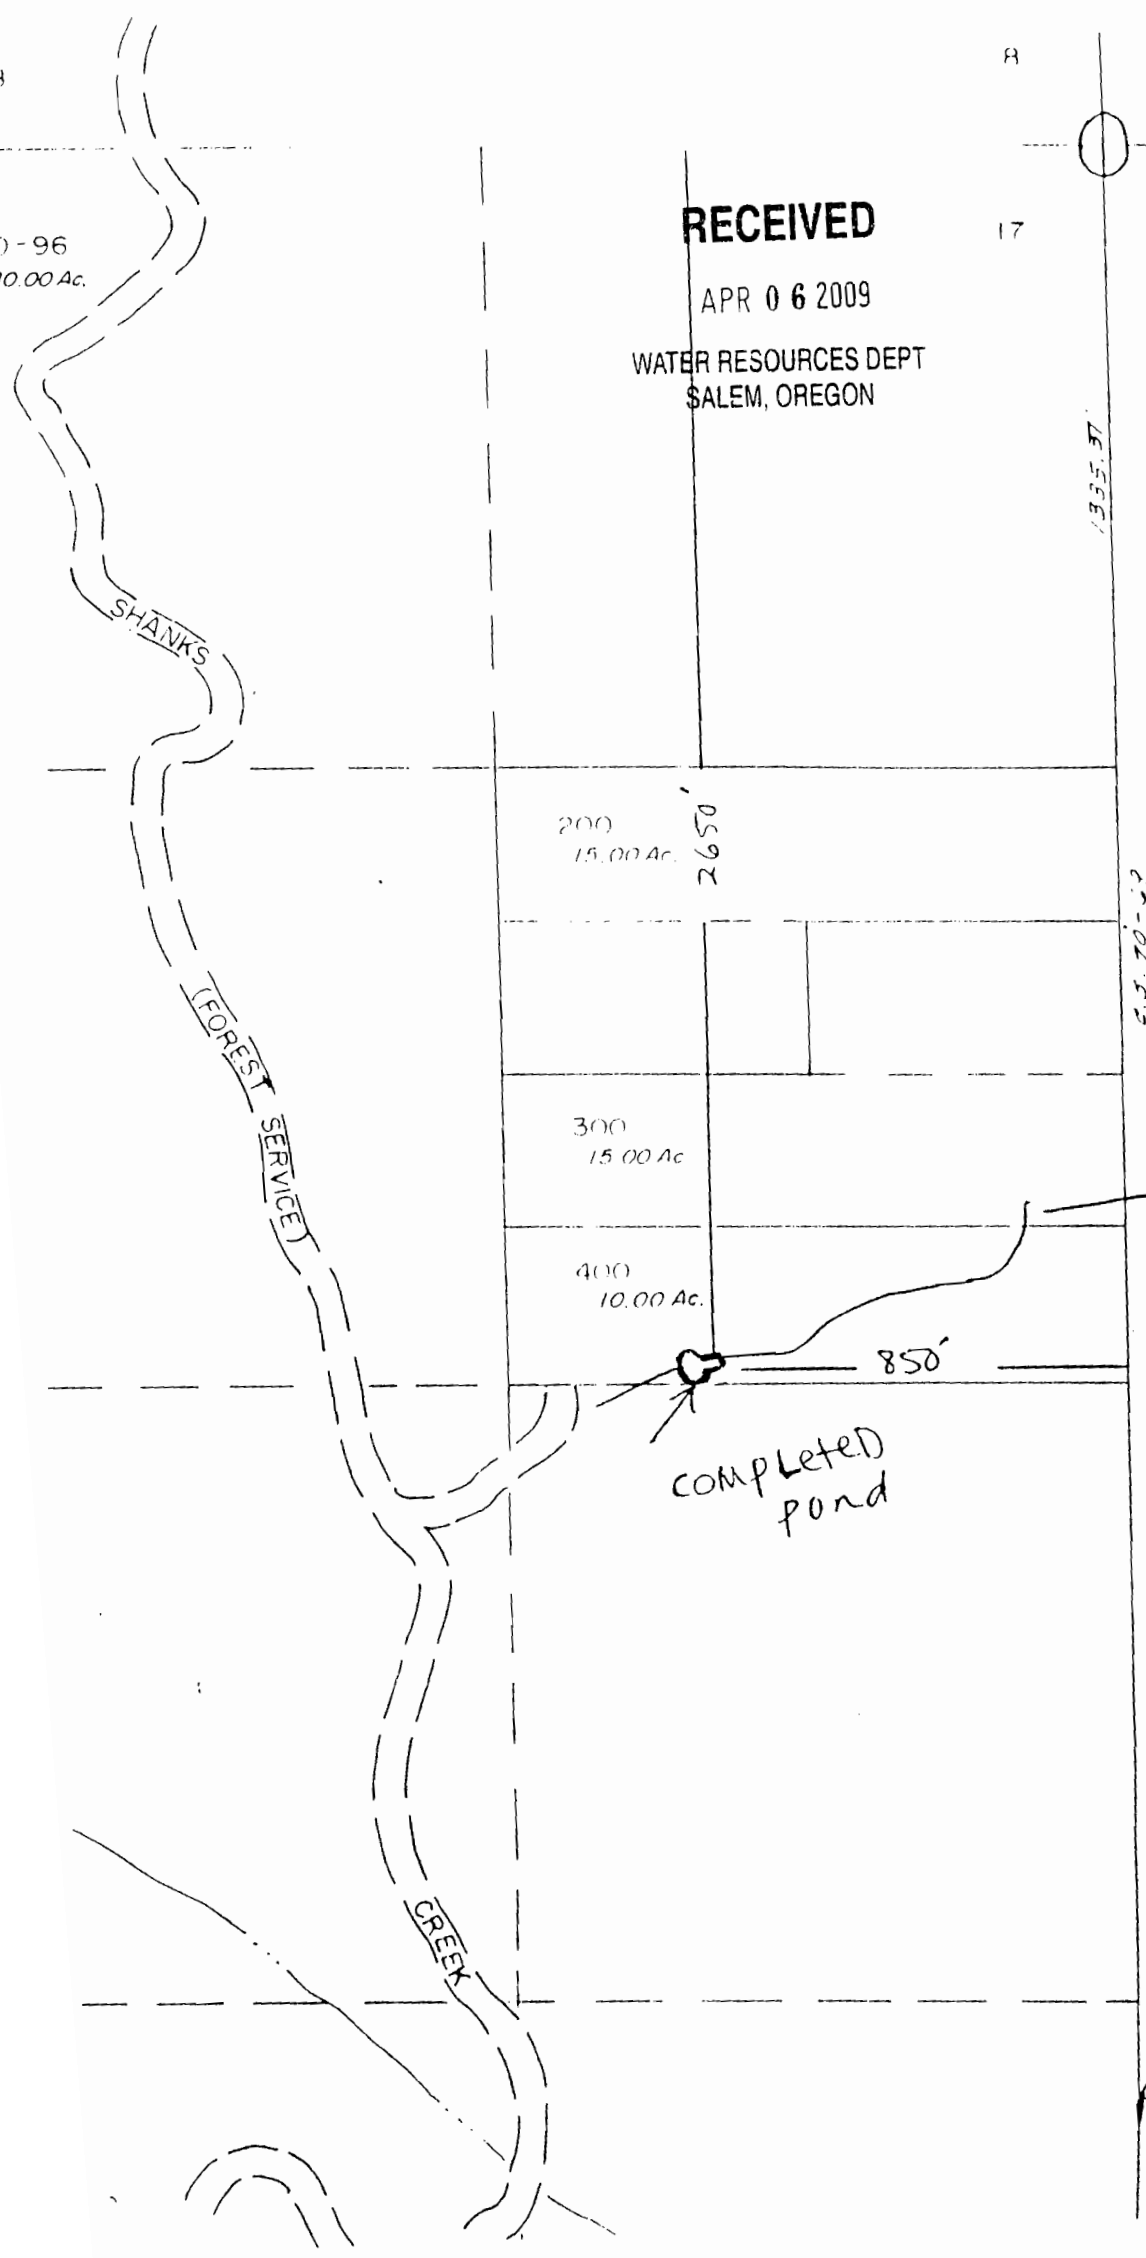

NE 1/4
CORNER

850' West
and
2650' South
of NE 1/4
Corner

Unnamed
Stream

SEE MAP 34 5

App No R 86386
Permit No R 14240