


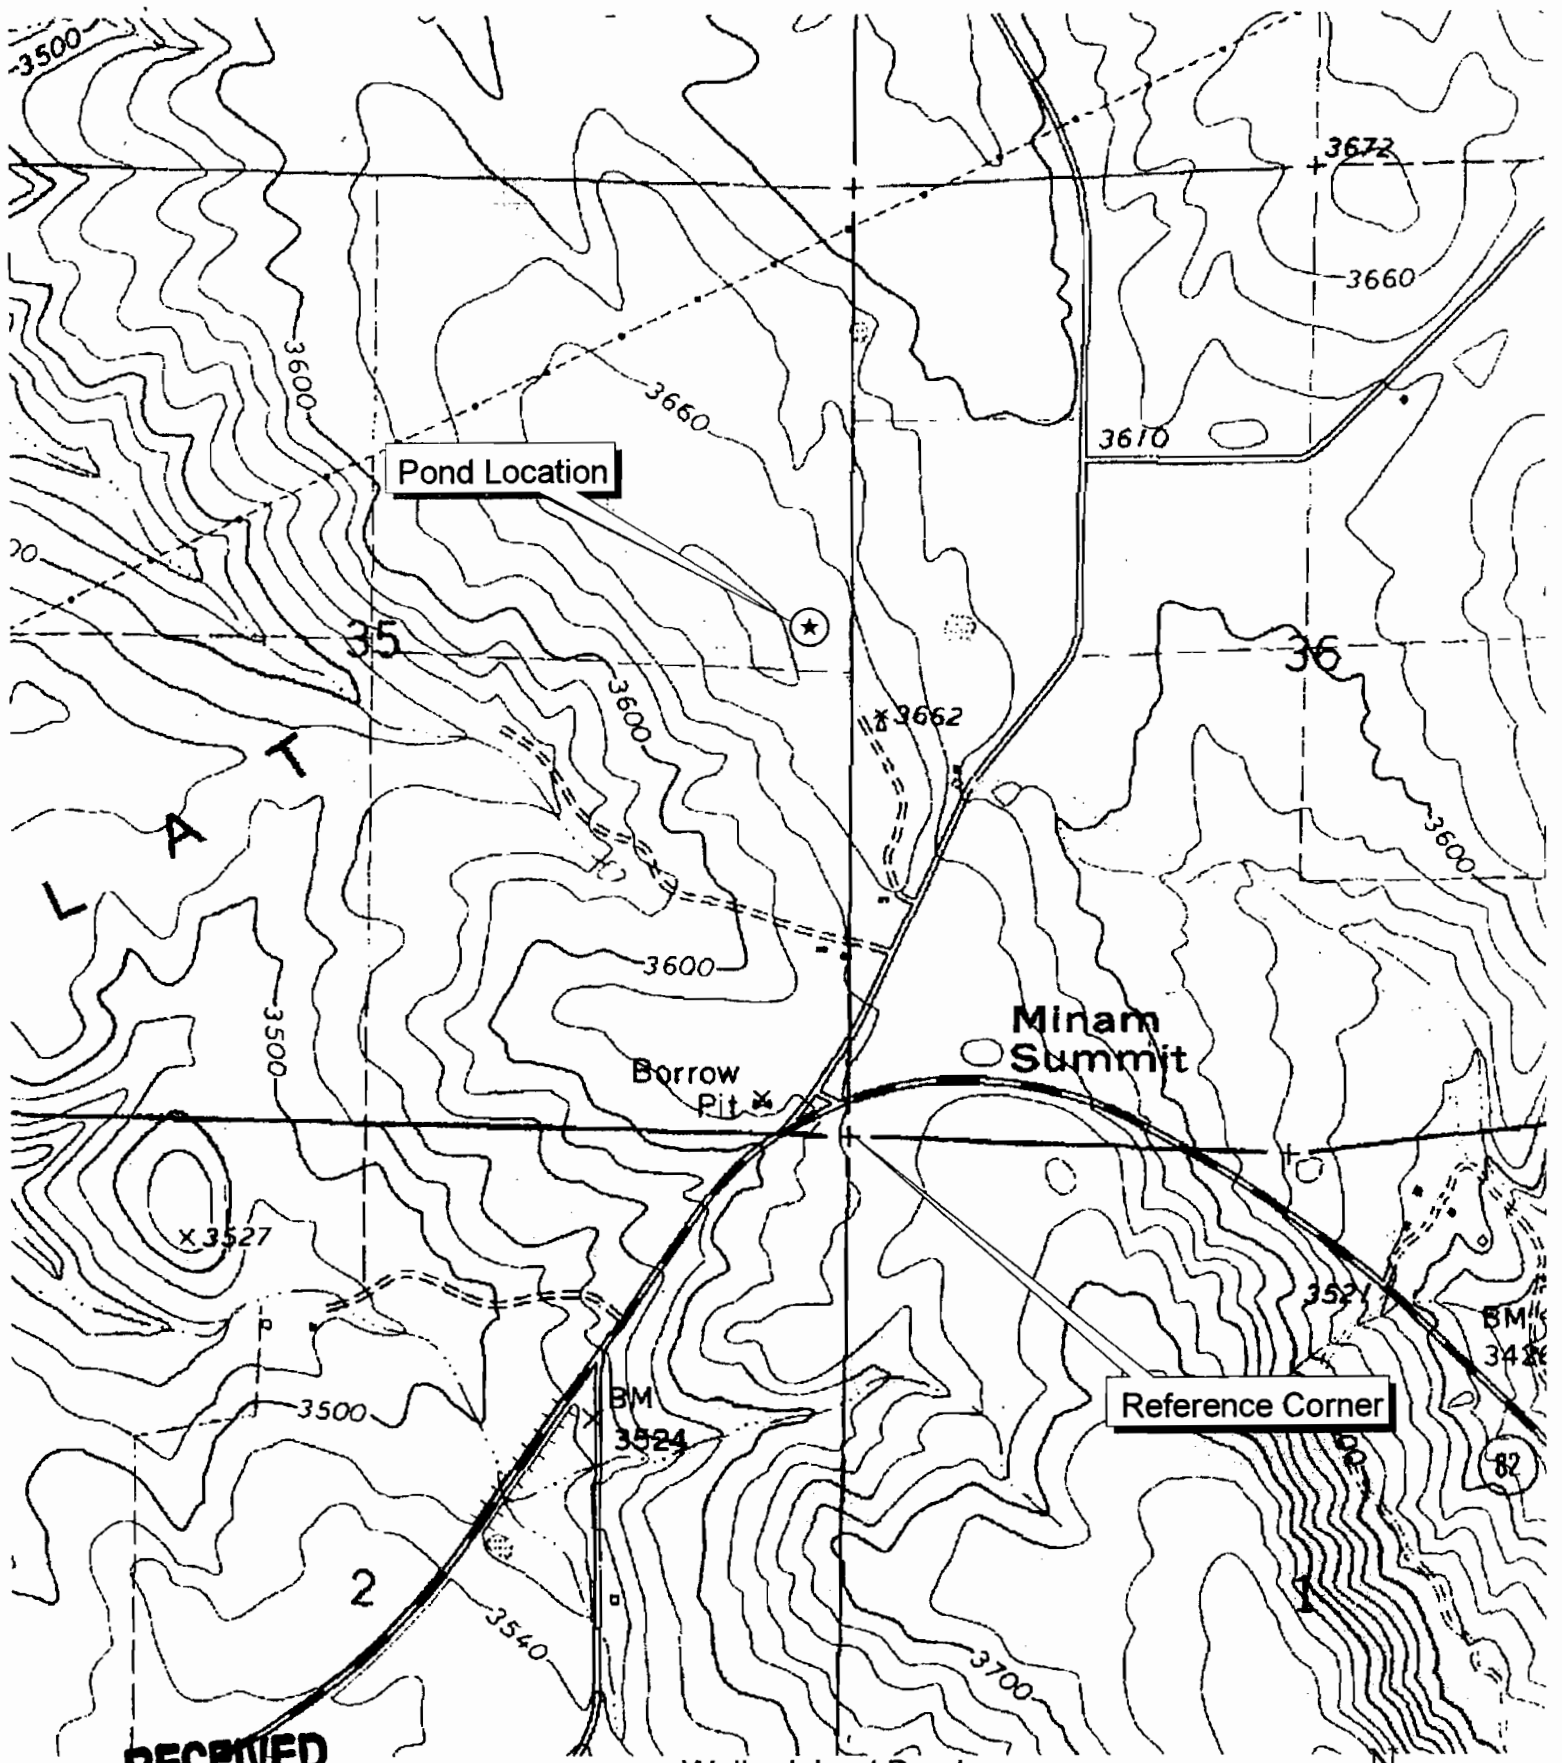

RECEIVED

NOV 03 2008

WATER RESOURCES DEPT
SALEM, OREGON

186848 R 14559

Waller Island Pond

T2N; R40E; Sec 35; SE 1/4 of NE 1/4

Tax Lot # 6700

Pond Location: From the SE corner of section 35

2850 feet North and 225' West

1" = 1000'

Cricket Flat Quad map Union County Oregon

RECEIVED

MAY 07 2001

WATER RESOURCES DEPT
SALEM, OREGON

