


RECEIVED

JUN 26 2008

WATER RESOURCES DEPT
SALEM, OREGON


Transfer of Water Right Map
RRIP, Limited
Certificate 65021 and 65061
T 35 S, R 1 W, Sec 31, W.M.

Map 1 of 3

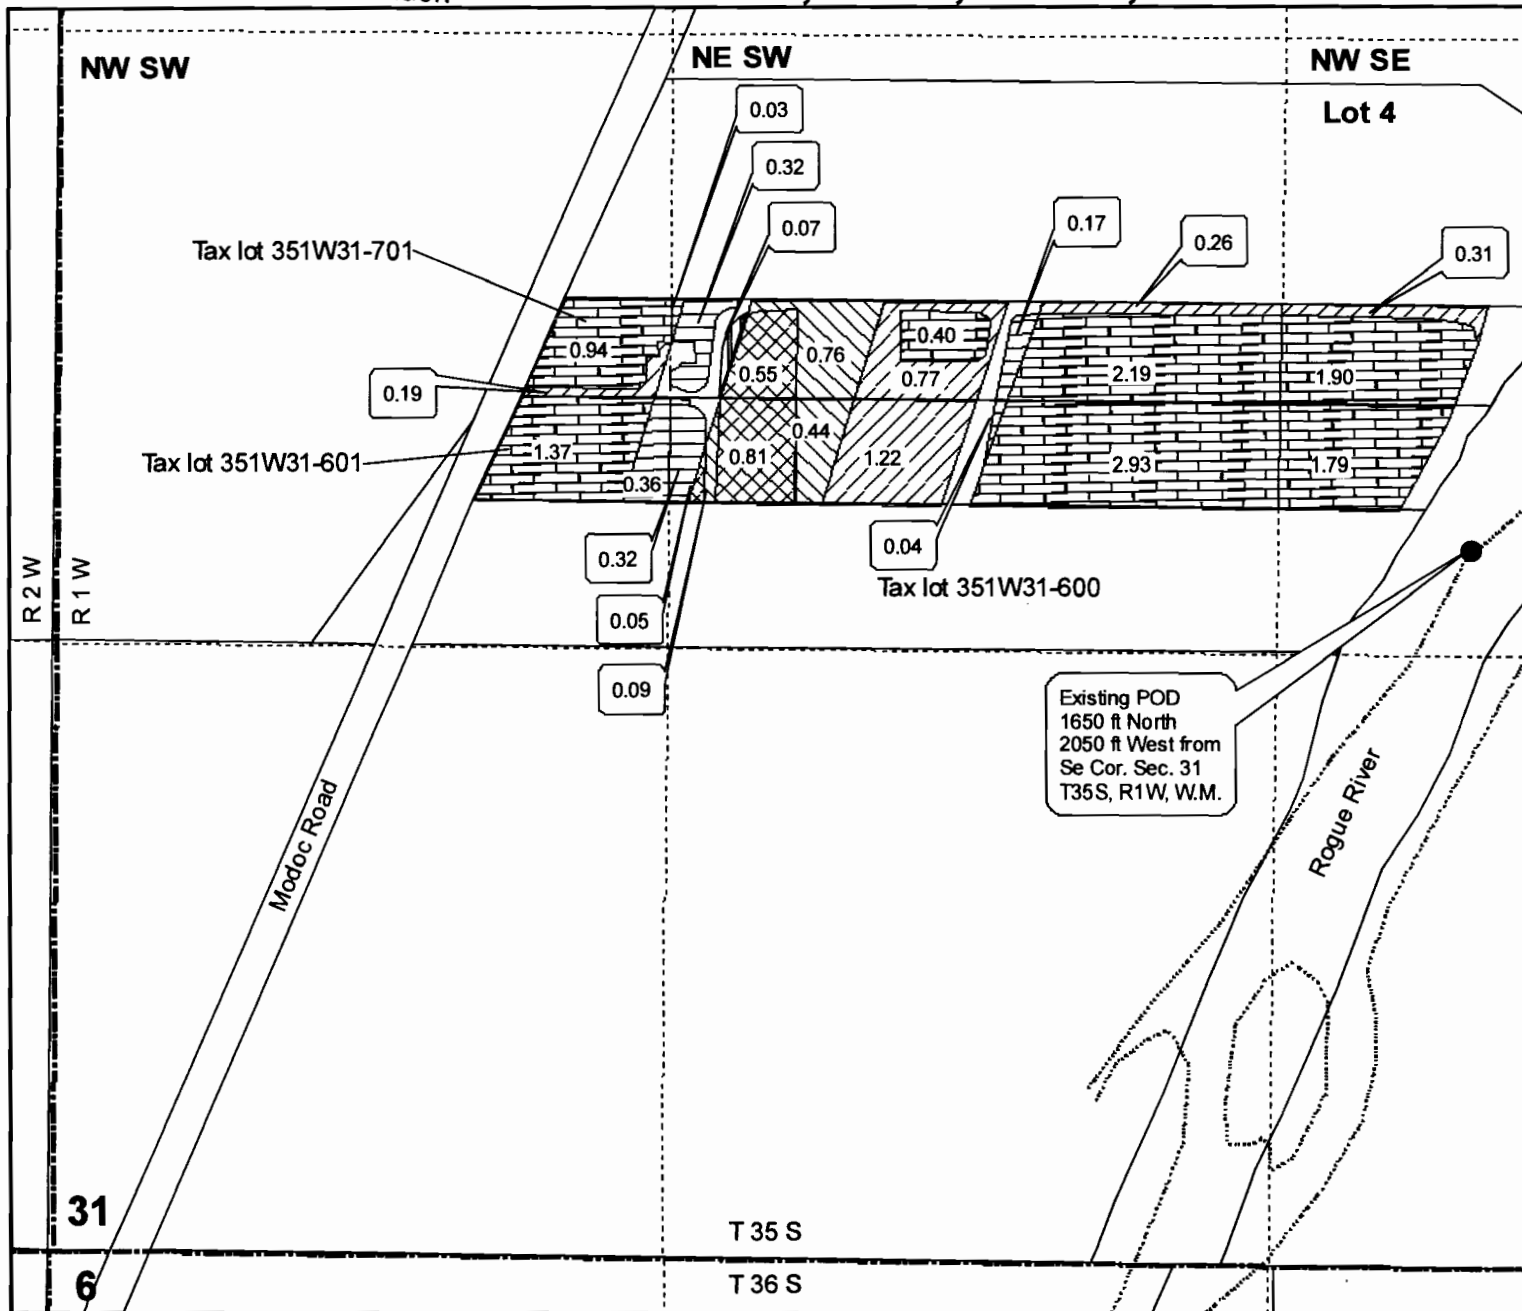

Legend

- Cert 65061 transfer to
- Cert 65021 remaining
- Cert 65021 transfer from
- Cert 65021 transfer to
- Cert 65061 remaining
- Cert 65061 transfer from

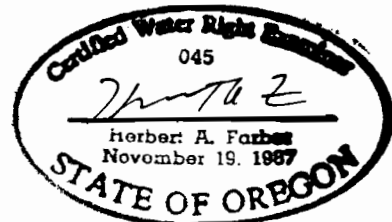

RENEWAL DATE 12-31-09

This map is not intended to provide legal dimensions or locations of property ownership lines.



PO Box 5286
Central Point, Oregon 97502
Phone 541-664-5599
Fax 541-664-5603
Email haFarber@charter.net

Farber & Sons, Inc.
421 Oak Street
Central Point, Oregon
Tax ID: 93-1057175


Transfer of Water Right Map
 RRIP, Limited
 Certificate 51195
T 35 S, R 1 W, Sec 31, W.M.

Map 2 of 3

RECEIVED



JUN 26 2008

WATER RESOURCES DEPT
 SALEM, OREGON

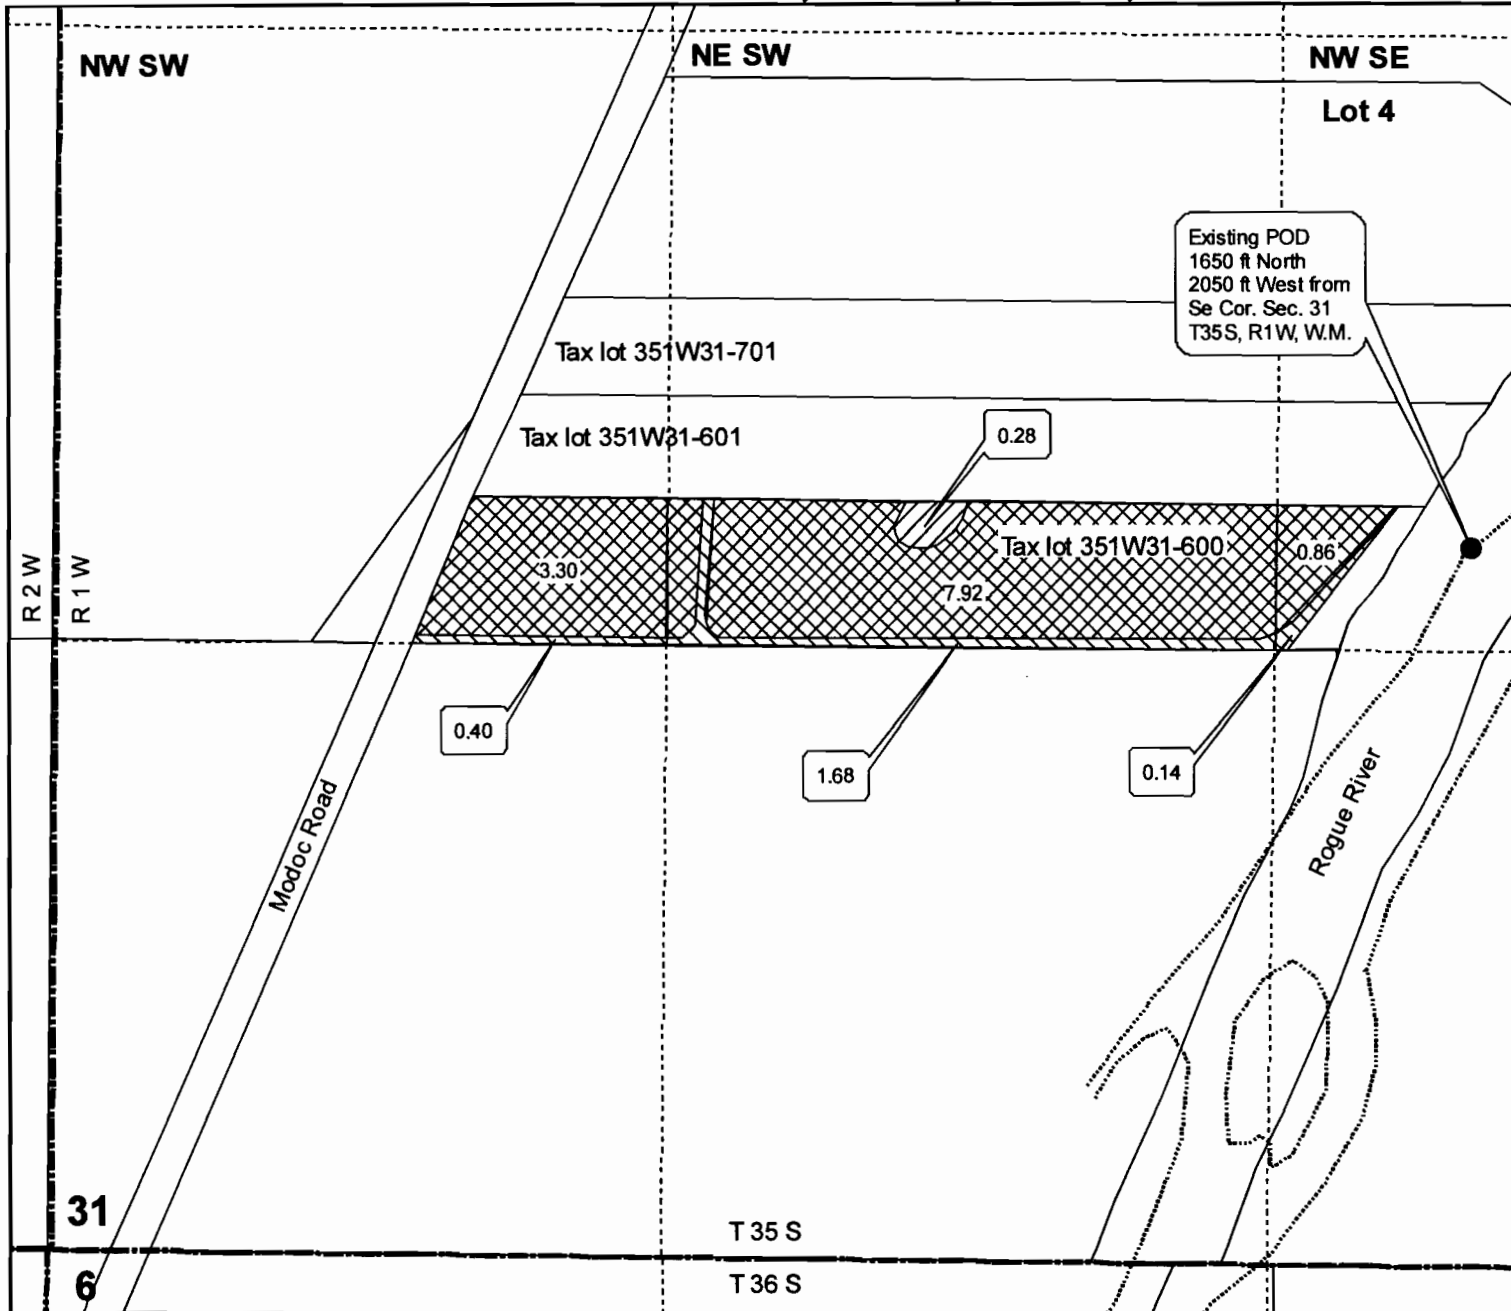

Legend

-  Unchanged
-  Transfer From
-  Transfer To

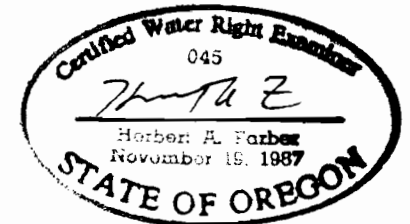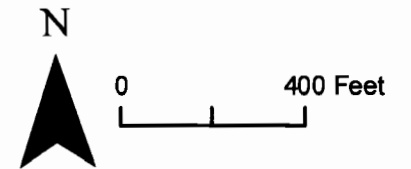

RENEWAL DATE 12-31-09

This map is not intended to provide legal dimensions or locations of property ownership lines.



PO Box 5286
 Central Point, Oregon 97502
 Phone 541-664-5599
 Fax 541-664-5603
 Email hfarber@charter.net

Farber & Sons, Inc.
 431 Oak Street
 Central Point, Oregon
 Tax ID: 93-1057173

RECEIVED


JUN 26 2008

WATER RESOURCES DEPT
SALEM, OREGON

Transfer of Water Right Map



RRIP, Limited
T 36 S, R 2 W, Sec 1, W.M.

Map 3 of 3

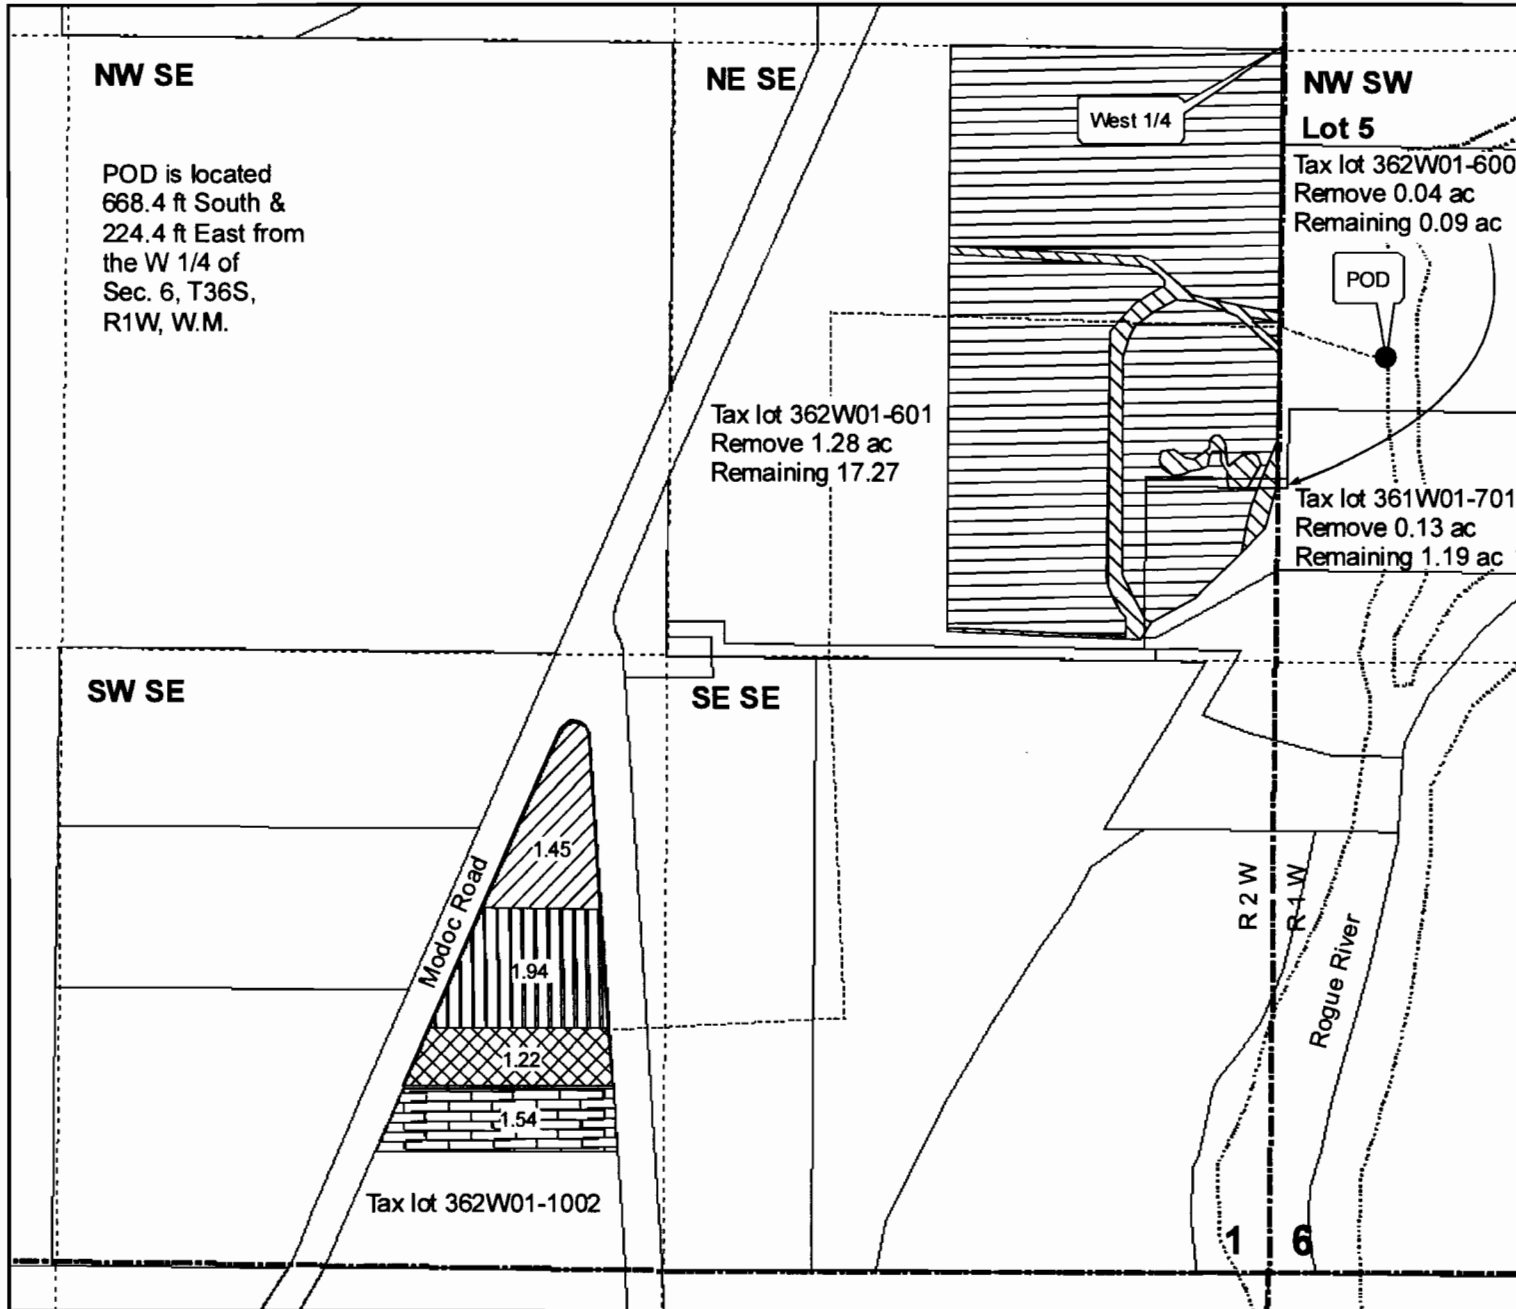

Legend

- T-8266 remaining
- T-8266 from
- T-8266 To
- 51195 to
- 65061 to
- 65021 to
- Pipe line

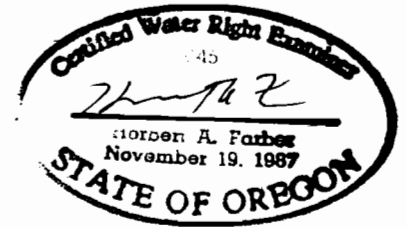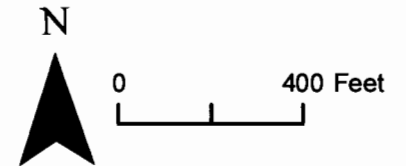

RENEWAL DATE 12-31-09

This map is not intended to
provide legal dimensions or
locations of property
ownership lines.



PO Box 5286
Central Point, Oregon 97502
Phone 541-664-5599
Fax 541-664-5603
Email ha@farber.com

Farber & Sons, Inc.
431 Oak Street
Central Point, Oregon
Tax ID: 93-1057173