


RECEIVED

JUN 26 2008

WATER RESOURCES DEPT  
SALEM, OREGON


Transfer of Water Right Map  
RRIP, Limited  
Certificate 65021 and 65061  
T 35 S, R 1 W, Sec 31, W.M.

Map 1 of 3

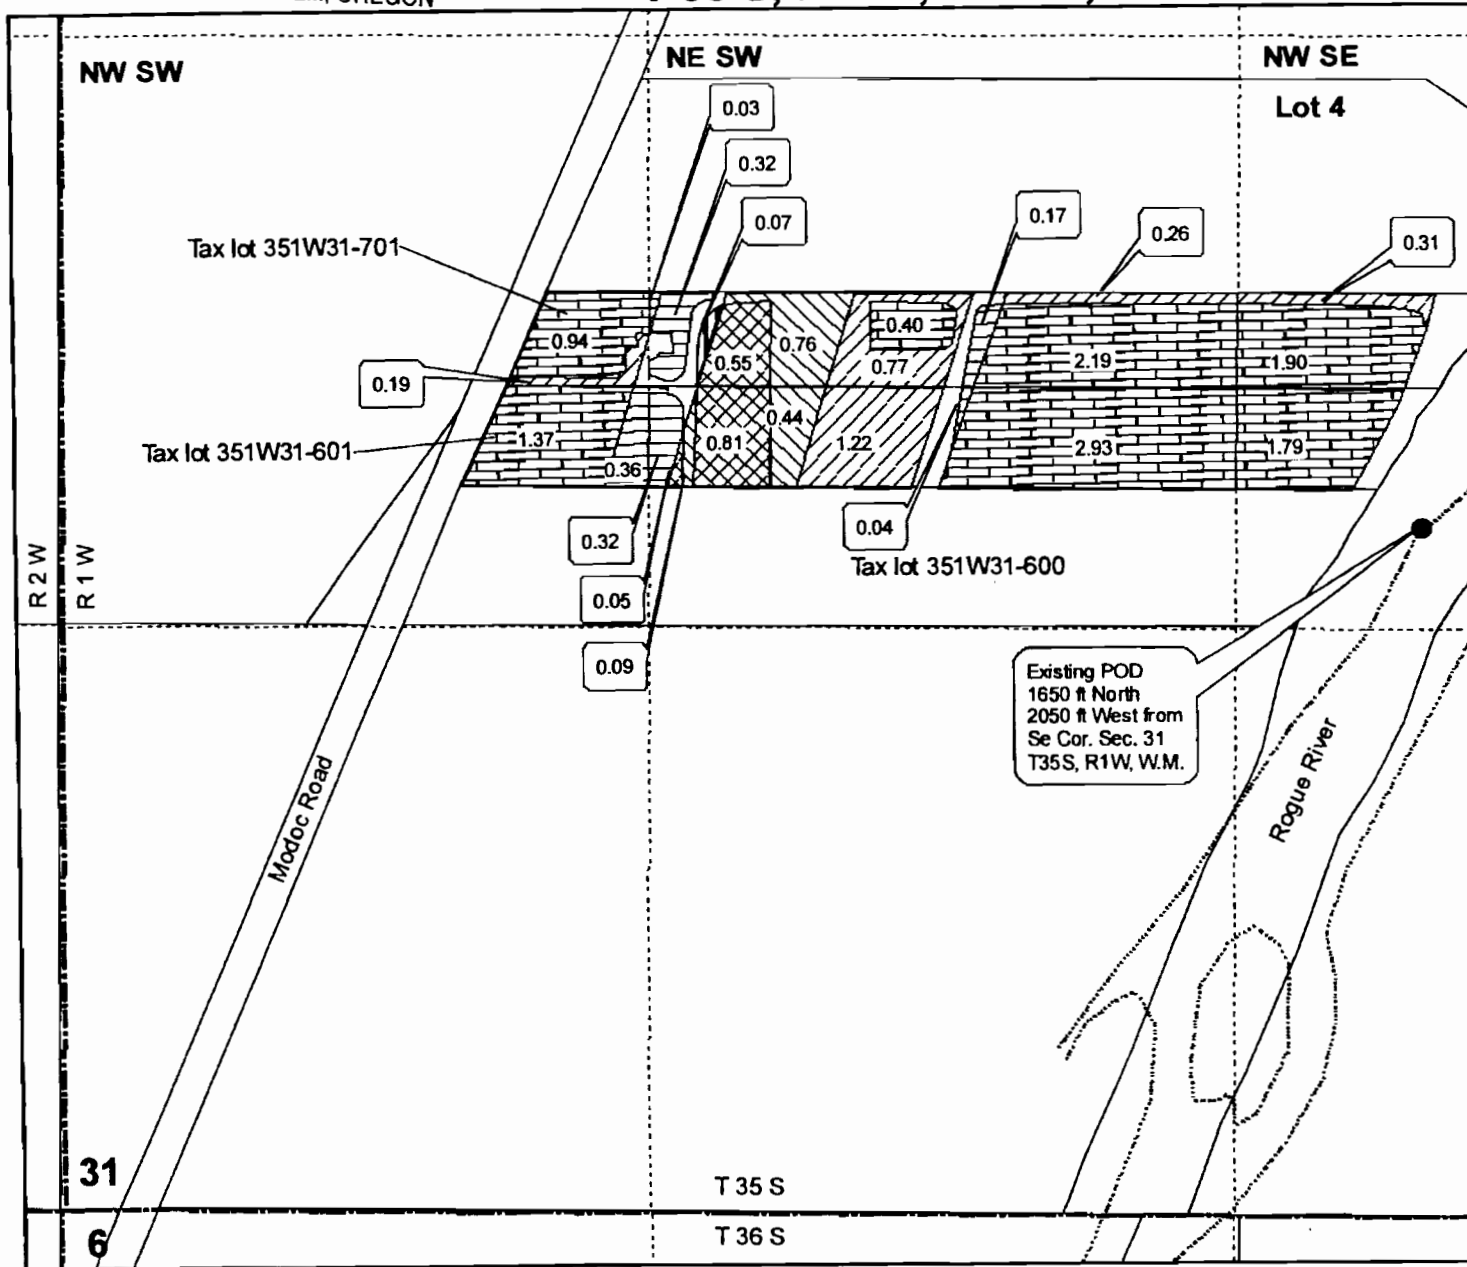

Legend

- Cert 65061 transfer to
- Cert 65021 remaining
- Cert 65021 transfer from
- Cert 65021 transfer to
- Cert 65061 remaining
- Cert 65061 transfer from

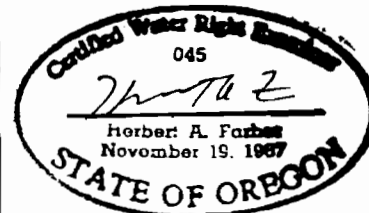

RENEWAL DATE 12-31-09

This map is not intended to provide legal dimensions or locations of property ownership lines.



PO Box 5286  
Central Point, Oregon 97502  
Phone 541-664-5599  
Fax 541-664-5603  
Email [haFarber@charter.net](mailto:haFarber@charter.net)

Farber & Sorn, Inc.  
431 Oak Street  
Central Point, Oregon  
Tax ID: 93-1057175