


**Transfer of Water Right Map**  
 RRIP, Limited  
 Certificate 51195  
**T 35 S, R 1 W, Sec 31, W.M.**

Map 2 of 3




**RECEIVED**



JUN 26 2008

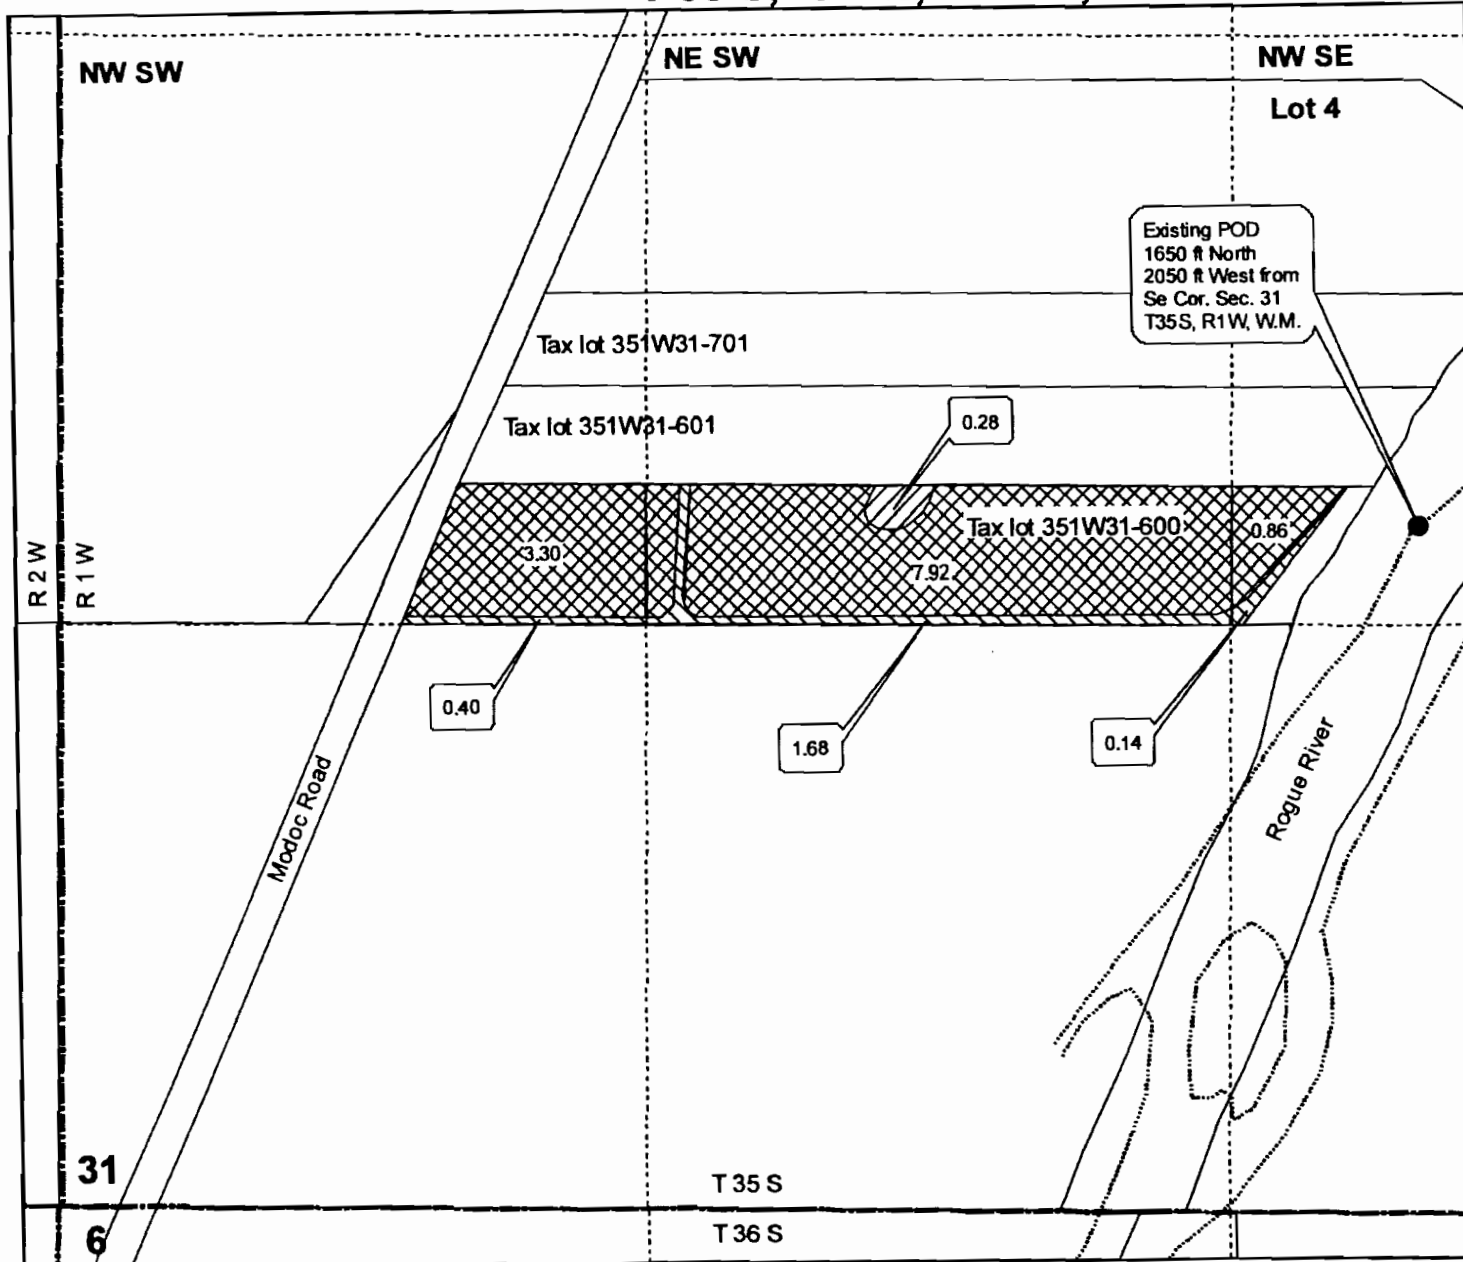WATER RESOURCES DEPT  
 SALEM, OREGON



**Legend**

-  Unchanged
-  Transfer From
-  Transfer To

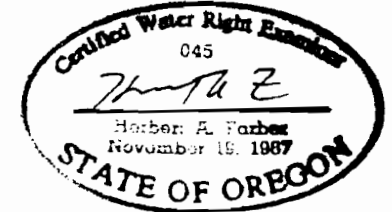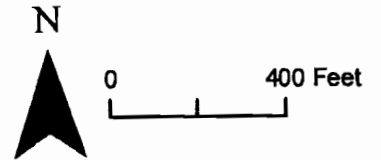

**RENEWAL DATE 12-31-09**

This map is not intended to provide legal dimensions or locations of property ownership lines.



PO Box 5286  
 Central Point, Oregon 97502  
 Phone 541-664-5599  
 Fax 541-664-5603  
 Email [harber@charter.net](mailto:harber@charter.net)

Farber & Sons, Inc.  
 431 Oak Street  
 Central Point, Oregon  
 Tax ID: 92-1057173