


T.39 S., R. 19 & 20 E.W.M.

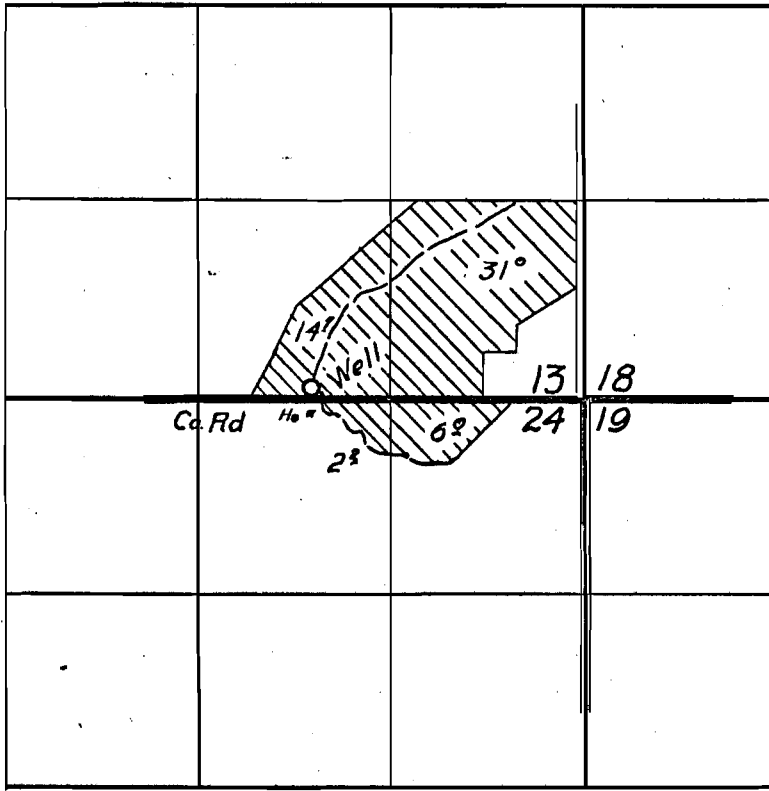

**FINAL PROOF SURVEY**  
 UNDER

Application No. U-355 Permit No. U-330  
 IN NAME OF

ELMO M. ANGELE

Surveyed 19 June 1955, by T. Jones