24489

26875

T.39S. R.19-20E.W.M.

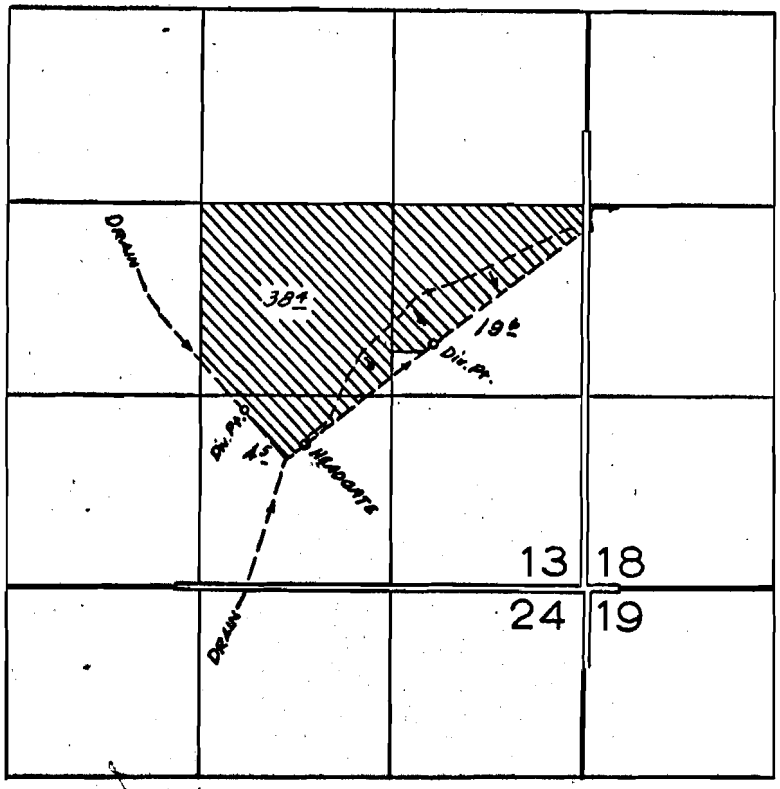

FINAL PROOF SURVEY
UNDER

Application No. 24791 Permit No. 24489
IN NAME OF

ELMO ANGELE

Surveyed May 13 1959, by R H Jackson

39-19,20 ✓

CHZ-38K-106