FINAL PROOF SURVEY

IN NAME OF

ROCK CREEK DISTRICT IMPROVEMENT CO.

APPLICATION NO. 17838 PERMIT NO. 15519
R-17837 R-780

SURVEYED SEPT. & OCT. 1957
& MARCH 1958
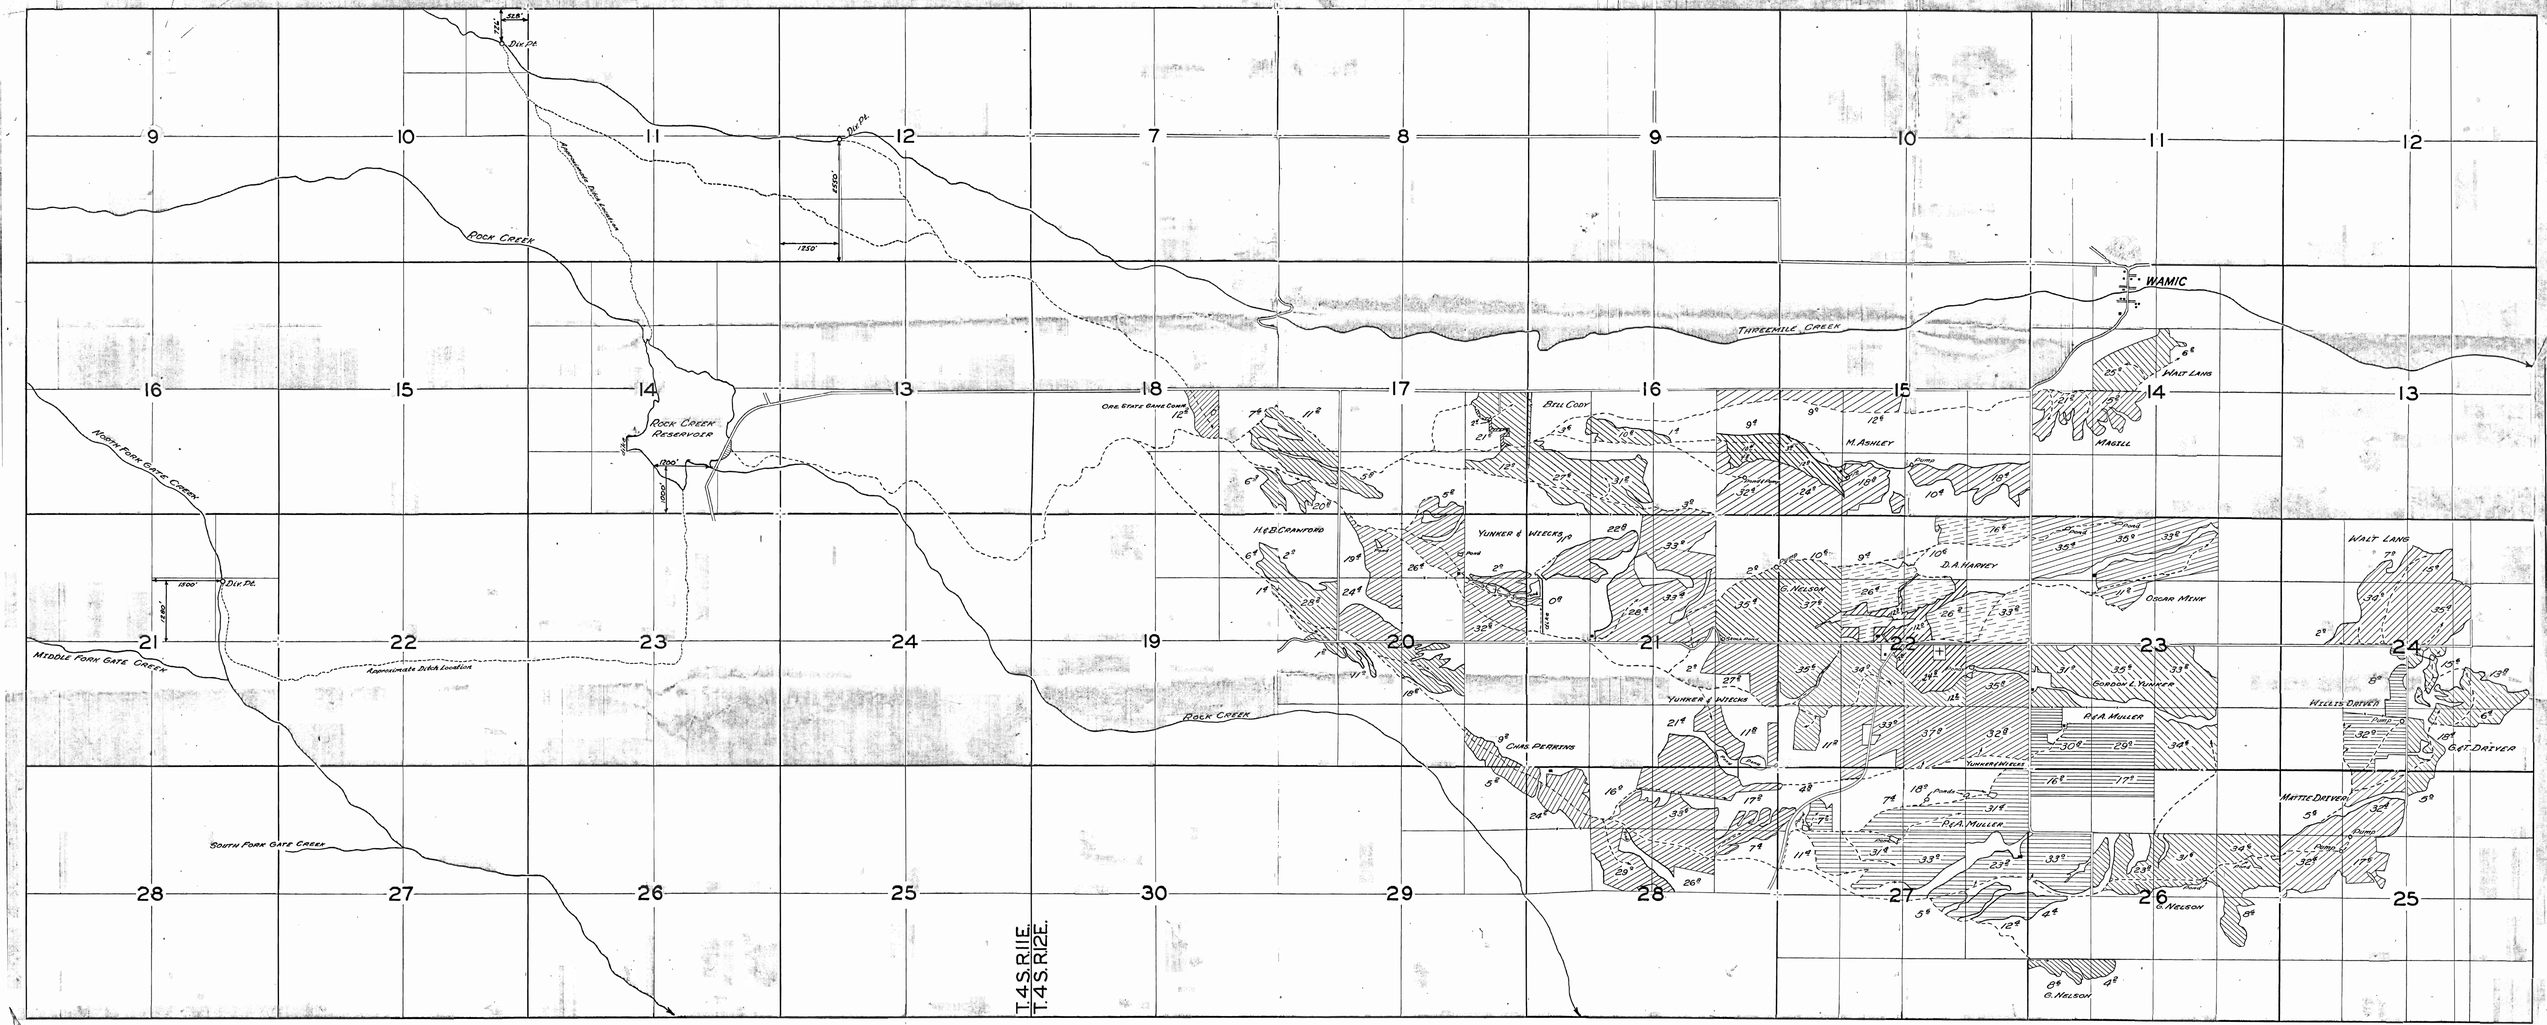
BY R. H. WHITBY