


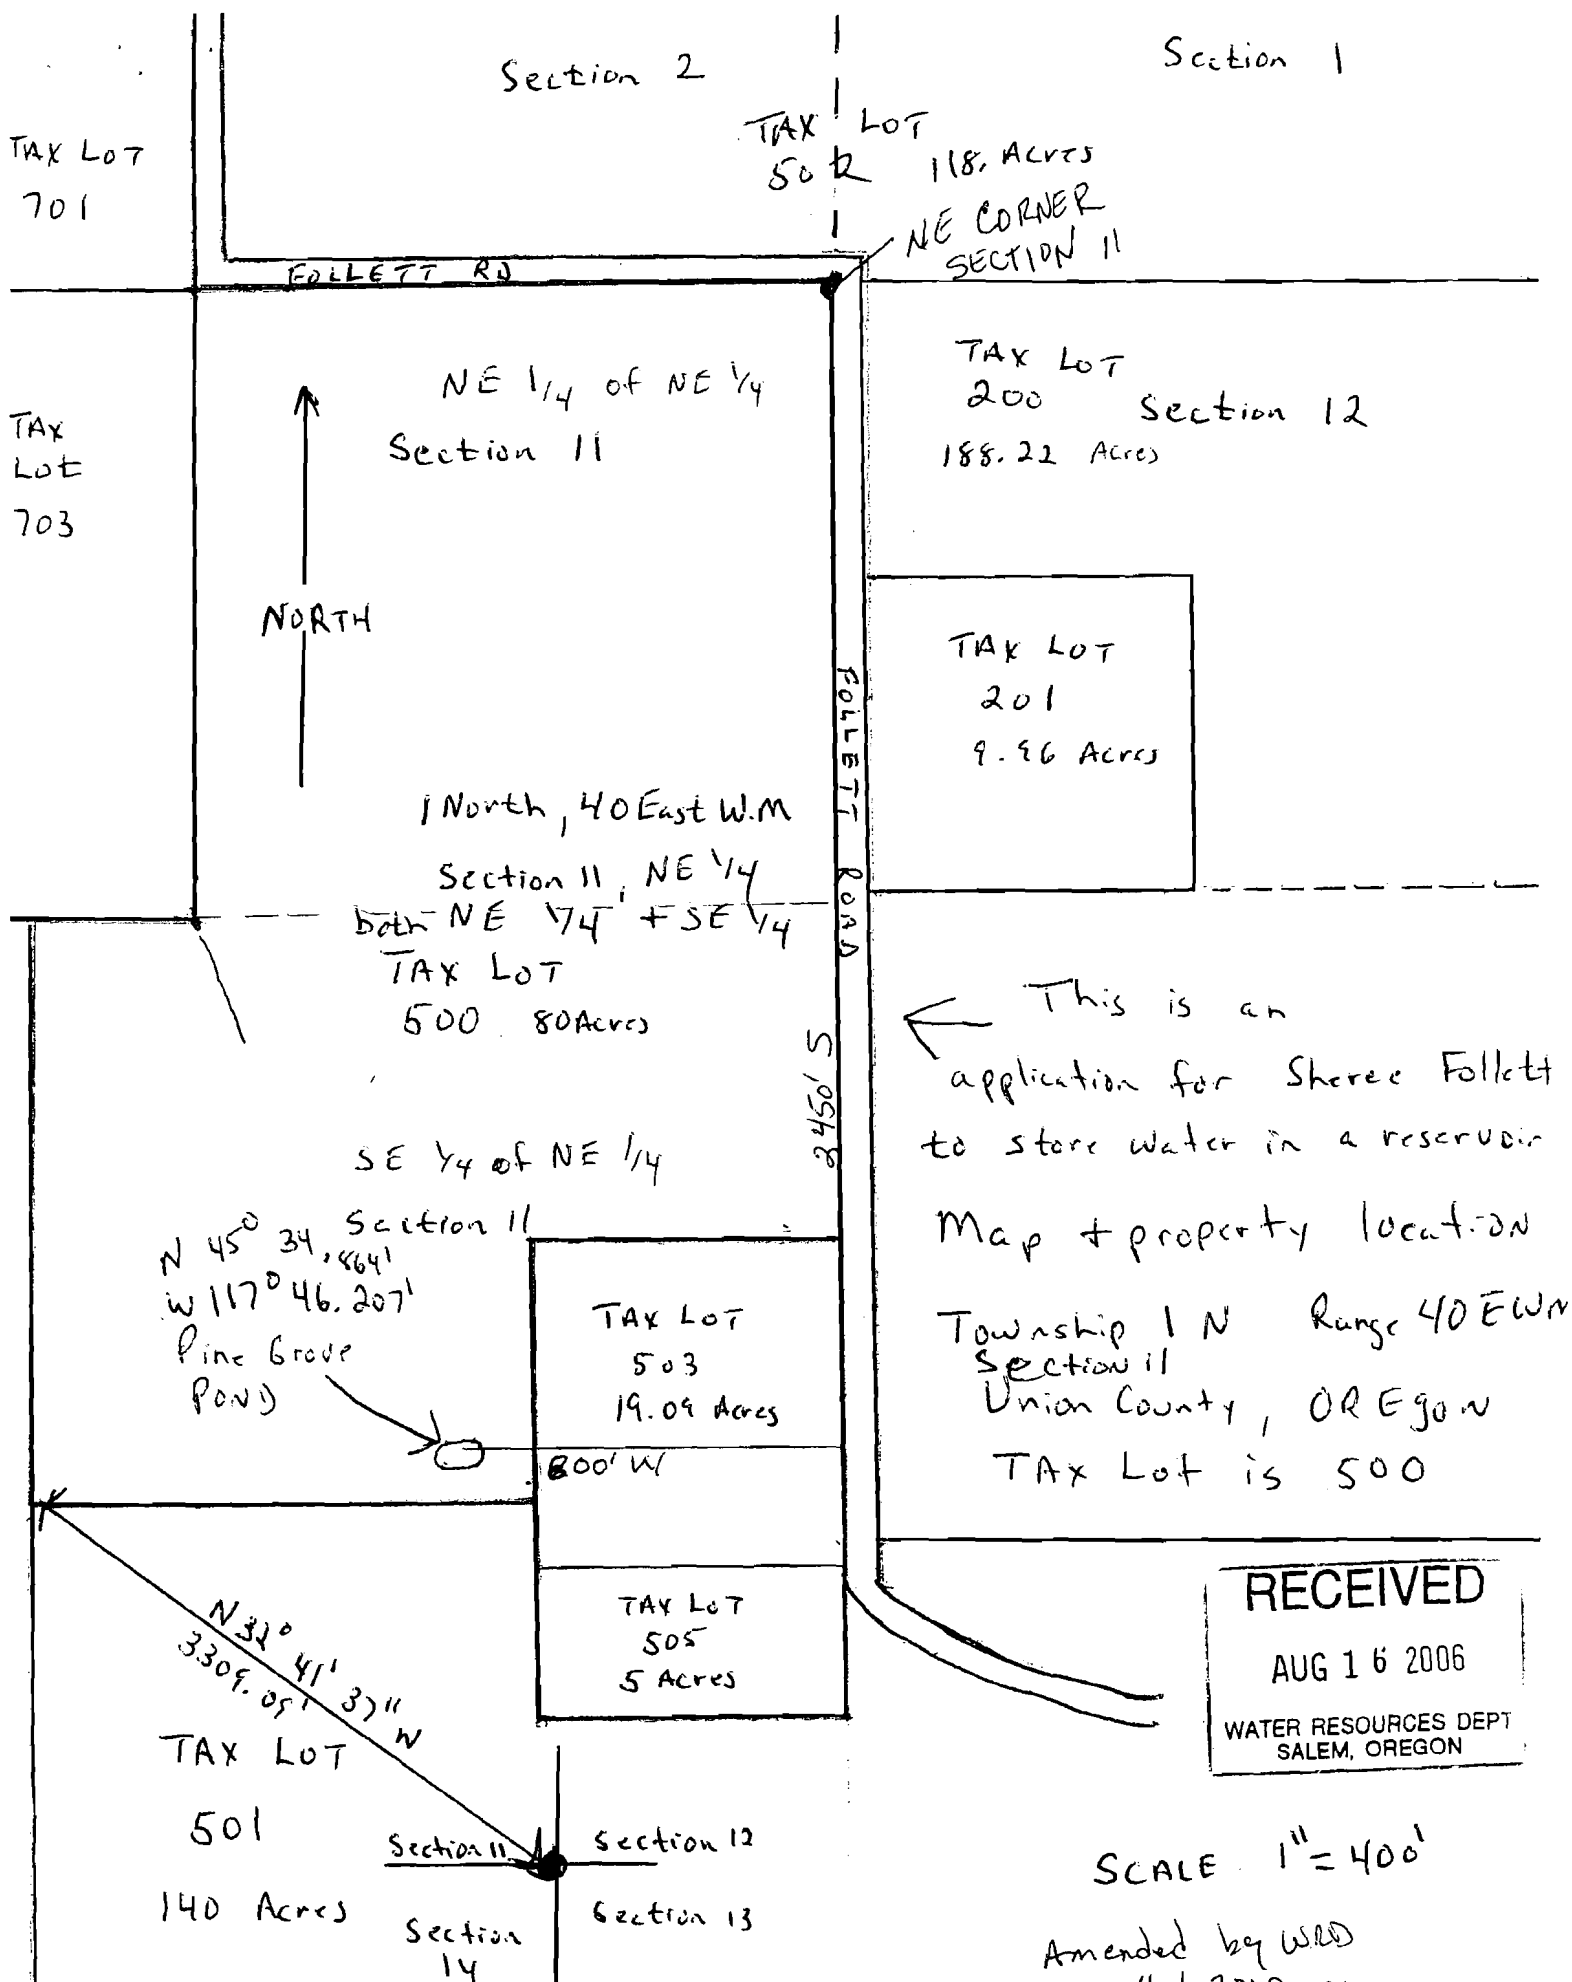

appno R-86672 Permit no R-14555

Section 2

Section 1

TAX LOT
701

TAX LOT
502 118. Acres

FOLLETT RD

NE 1/4 of NE 1/4
Section 11

TAX
LOT
703

NORTH

TAX LOT
200 Section 12
188.22 Acres

TAX LOT
201
9.96 Acres

RECEIVED

NOV 20 2008

WATER RESOURCES DEPT
SALEM, OREGON

1 North, 40 East W.M
Section 11, NE 1/4
both NE 1/4 + SE 1/4
TAX LOT
500 80 Acres

SE 1/4 of NE 1/4

Pine Grove
POND

TAX LOT
503
19.09 Acres

TAX LOT
505
5 Acres

← This is an
application for Sherac Follett
to store water in a reservoir
Map + property location
Township 1 N Range 40 E W
Section 11
Union County, OREGON
TAX Lot is 500

RECEIVED

AUG 16 2006

WATER RESOURCES DEPT
SALEM, OREGON

N 31° 41' 37" W
3309.05'

TAX LOT

501

140 Acres

Section 11
Section 14

Section 12
Section 13

SCALE 1" = 400'