


Section 8, T. 9 S., R. 3 W., W.M.

Point of diversion is 1869 feet West and 2446 feet South of the Northeast Corner of Section 8, T. 9 S., R. 3 W., W.M.

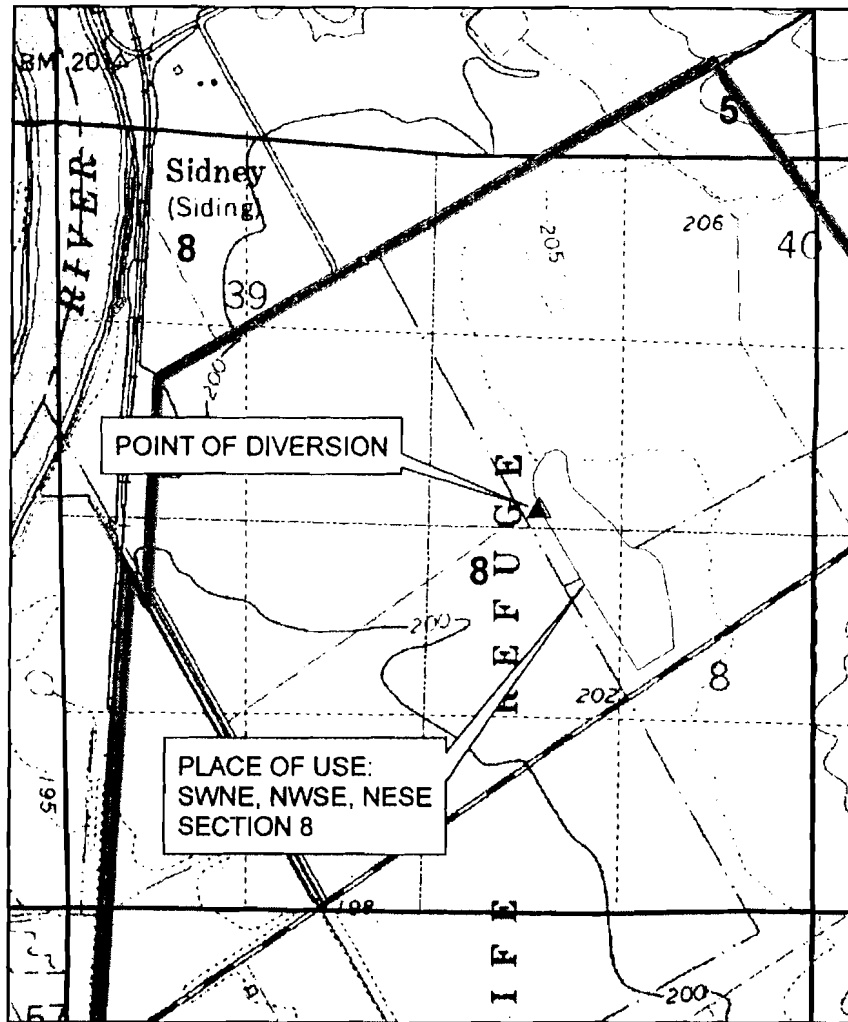

RECEIVED

FEB 06 2009

WATER RESOURCES DEPT
SALEM, OREGON



RECEIVED

SEP 24 2002

WATER RESOURCES DEPT.
SALEM, OREGON

FOXTAIL MARSH



1 inch equals 1,320 feet

The purpose of this map is to identify the location of the water right. It is not intended to provide information relative to the location of property ownership boundary lines.