


**APPLICATION MAP**  
**IN THE NAME OF U.S. FISH AND WILDLIFE SERVICE**  
**Section 8, T. 9 S., R. 3 W., W.M.**

Point of diversion is 1566 feet West and 2285 feet South of the Northeast Corner of Section 8, T. 9 S., R. 3 W., W.M.

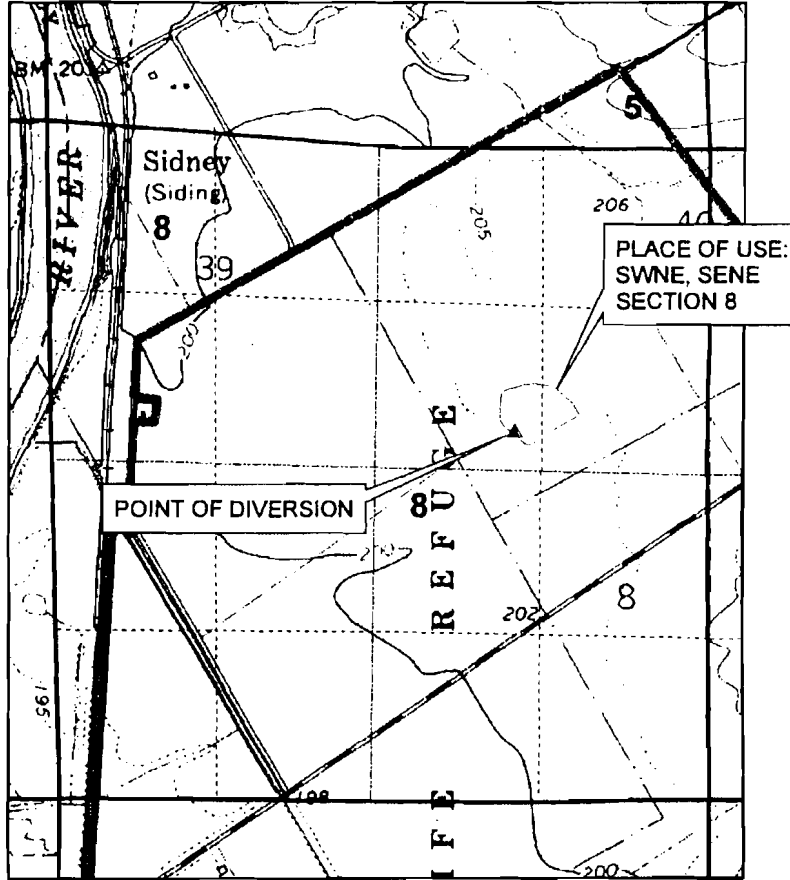

**RECEIVED**

FEB 06 2009


WATER RESOURCES DEPT.  
 SALEM, OREGON

**RECEIVED**

SEP 24 2002

WATER RESOURCES DEPT.  
 SALEM, OREGON

**COTTONWOOD POND**

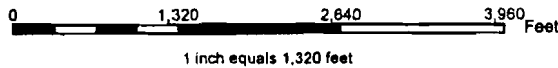

The purpose of this map is to identify the location of the water right. It is not intended to provide information relative to the location of property ownership boundary lines.