


Reservoir (Pond) Location  
DAM.

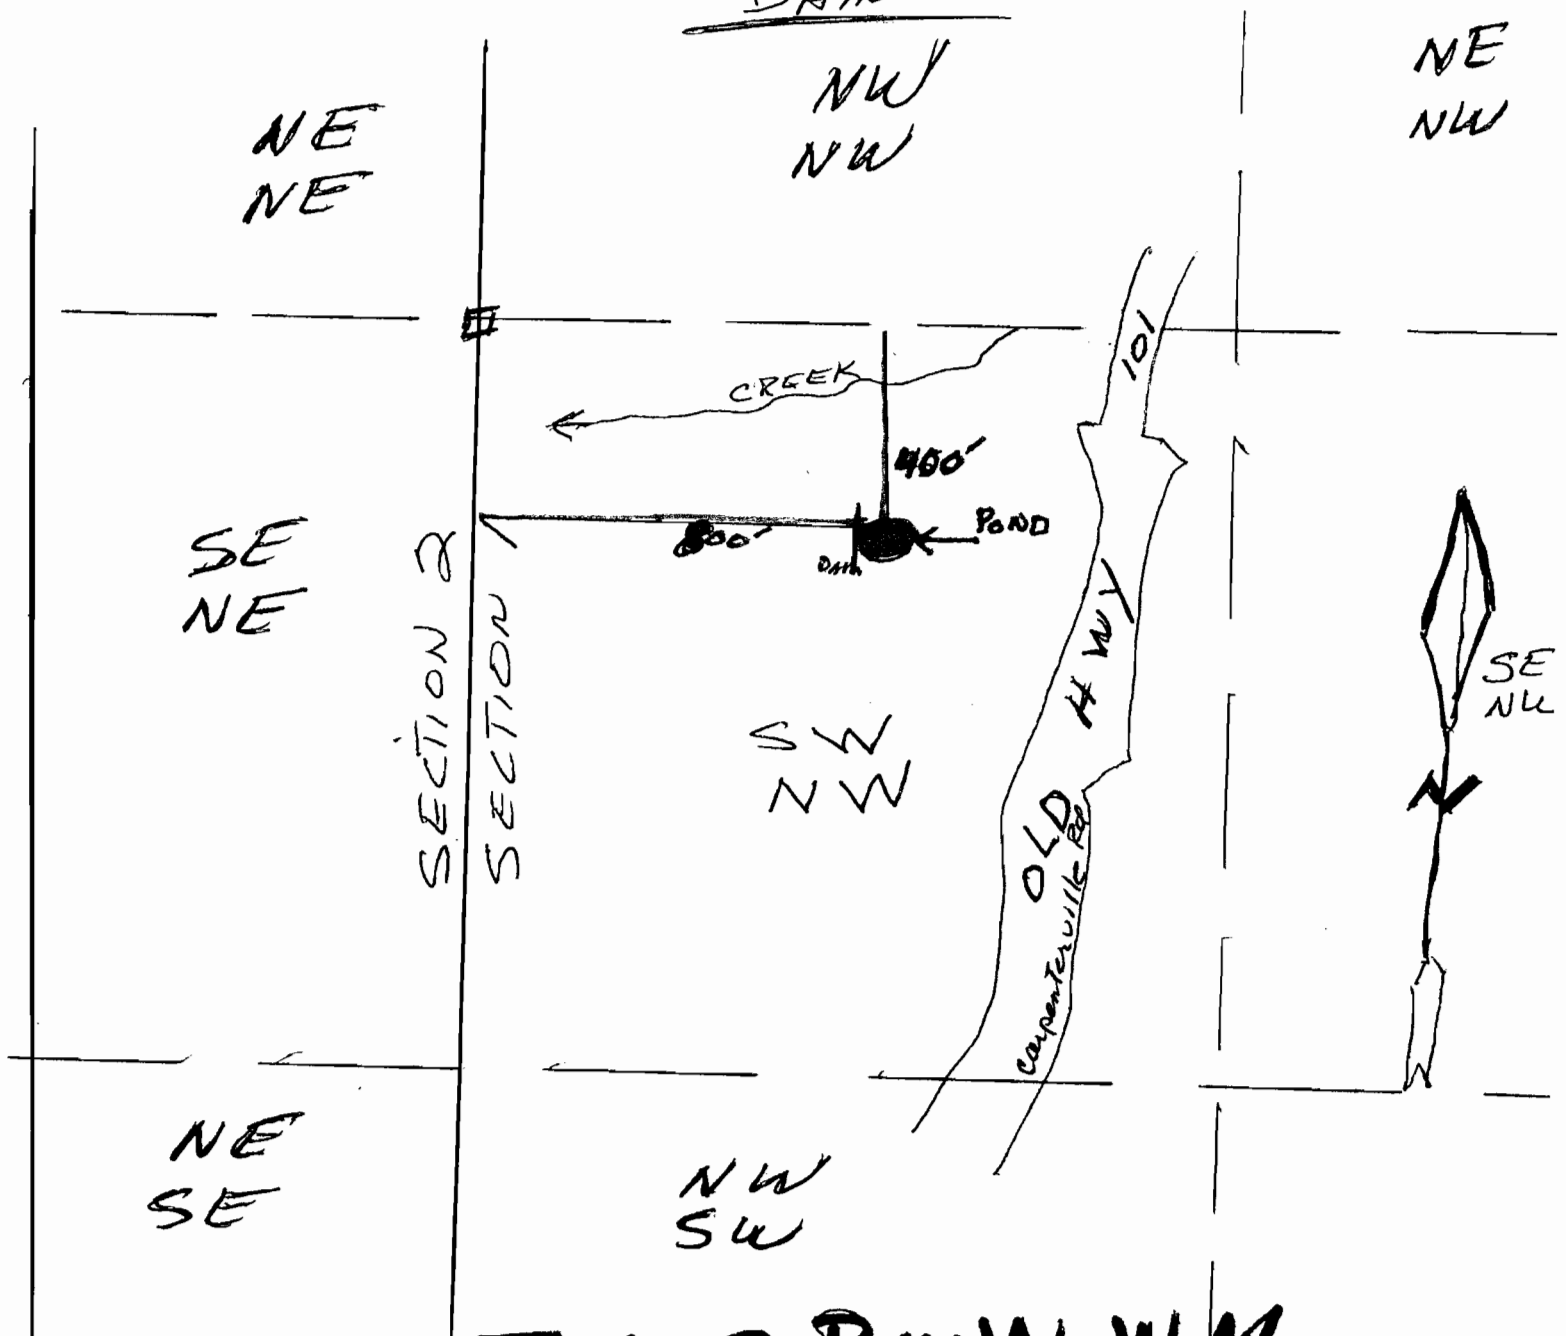

T 40 S, R 14 W, W.M.,  
SECTION 1  
TAX LOT 307

1" = 400ft

RECEIVED

FEB 25 2009

WATER RESOURCES DEPT  
SALEM, OREGON