


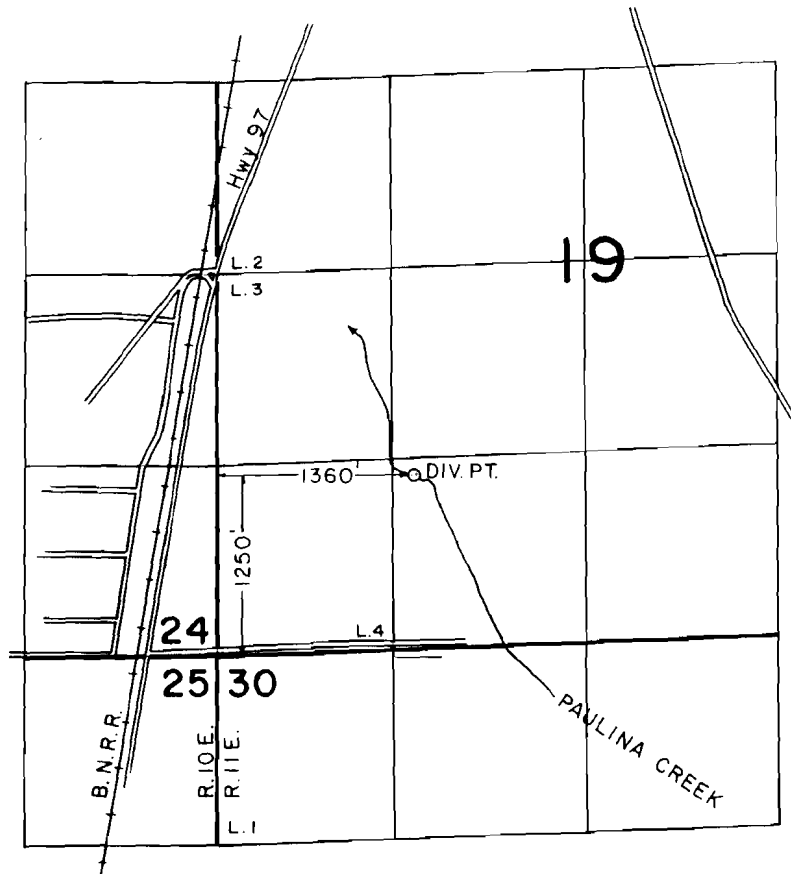

T. 21 S., R. 10 & 11 E., W.M.



SCALE: 1" = 1320'

FINAL PROOF SURVEY

UNDER

TRANSFER NO. 5713

Application No. Permit No.
IN NAME OF

KELLEMS / ROSMAN

Surveyed DEC. 21, 1989, by B. W. BISHOP