


FINAL PROOF SURVEY
UNDER

TRANSFER 5849
APPL. 68848 PER. 49909
IN NAME OF
LOVENESS FARMS

Surveyed 8-19, 1987, by V.L. CHURCH

7

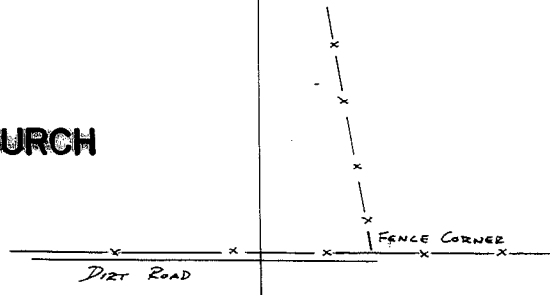

610

MILL CREEK
Div. Pt.

1330'


POND

DITCH


L.1

L.2

L.3

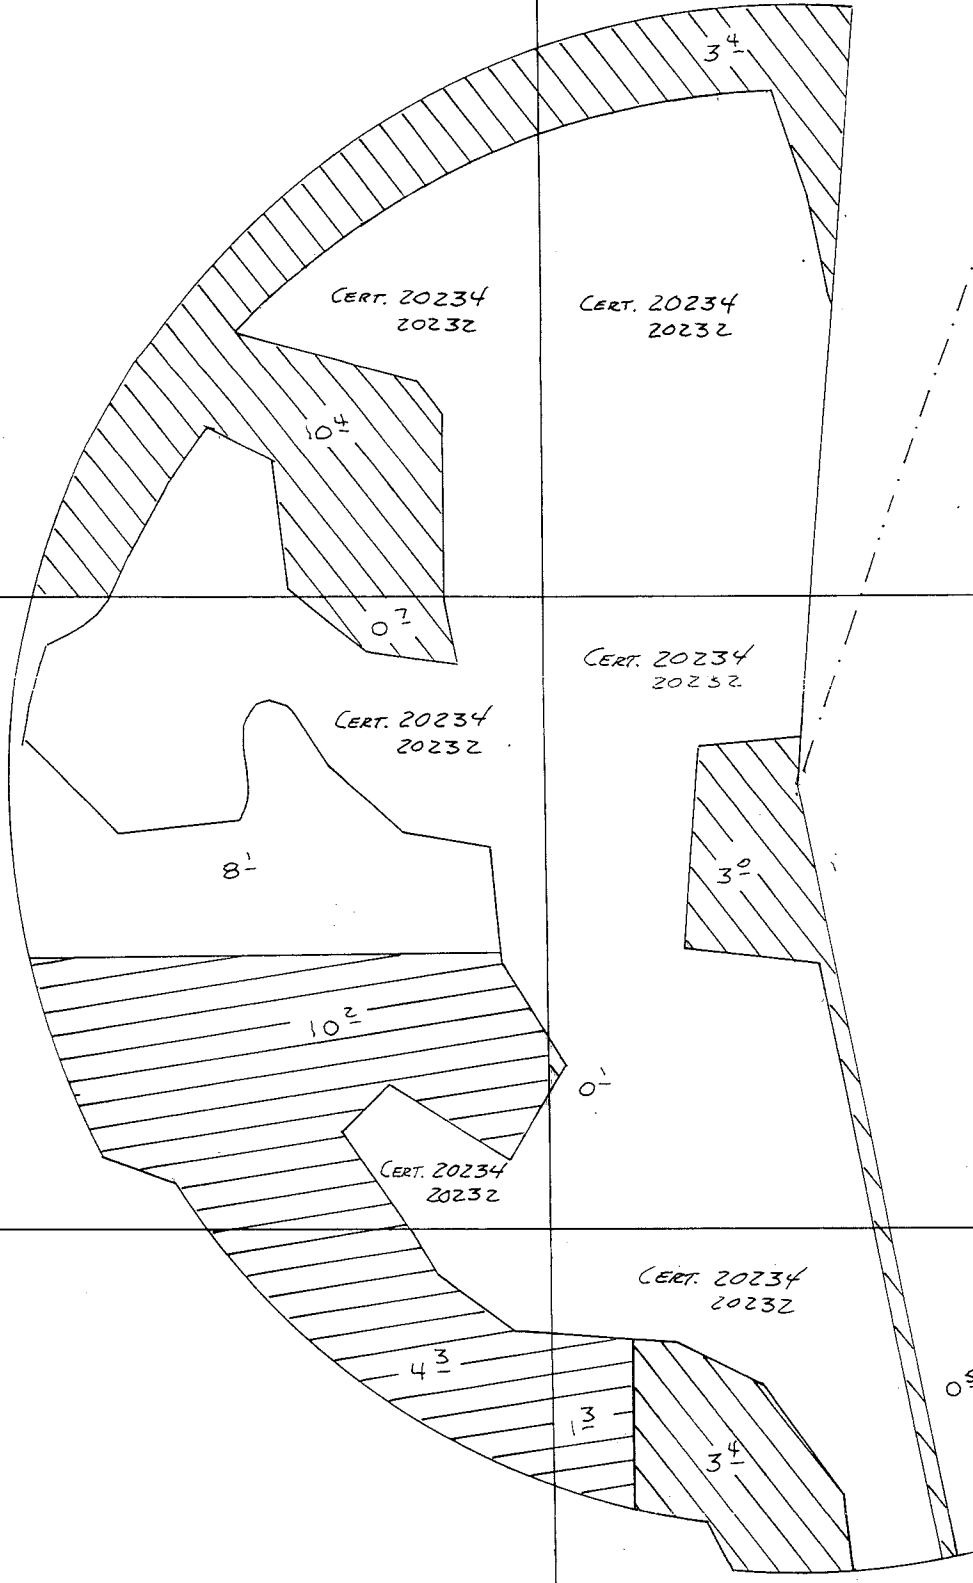

SCALE 1" = 400'

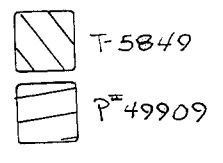

PTS.

2-16-89 V.L.C.