


Sec.

Tp.

R.

13-26-

13-27-

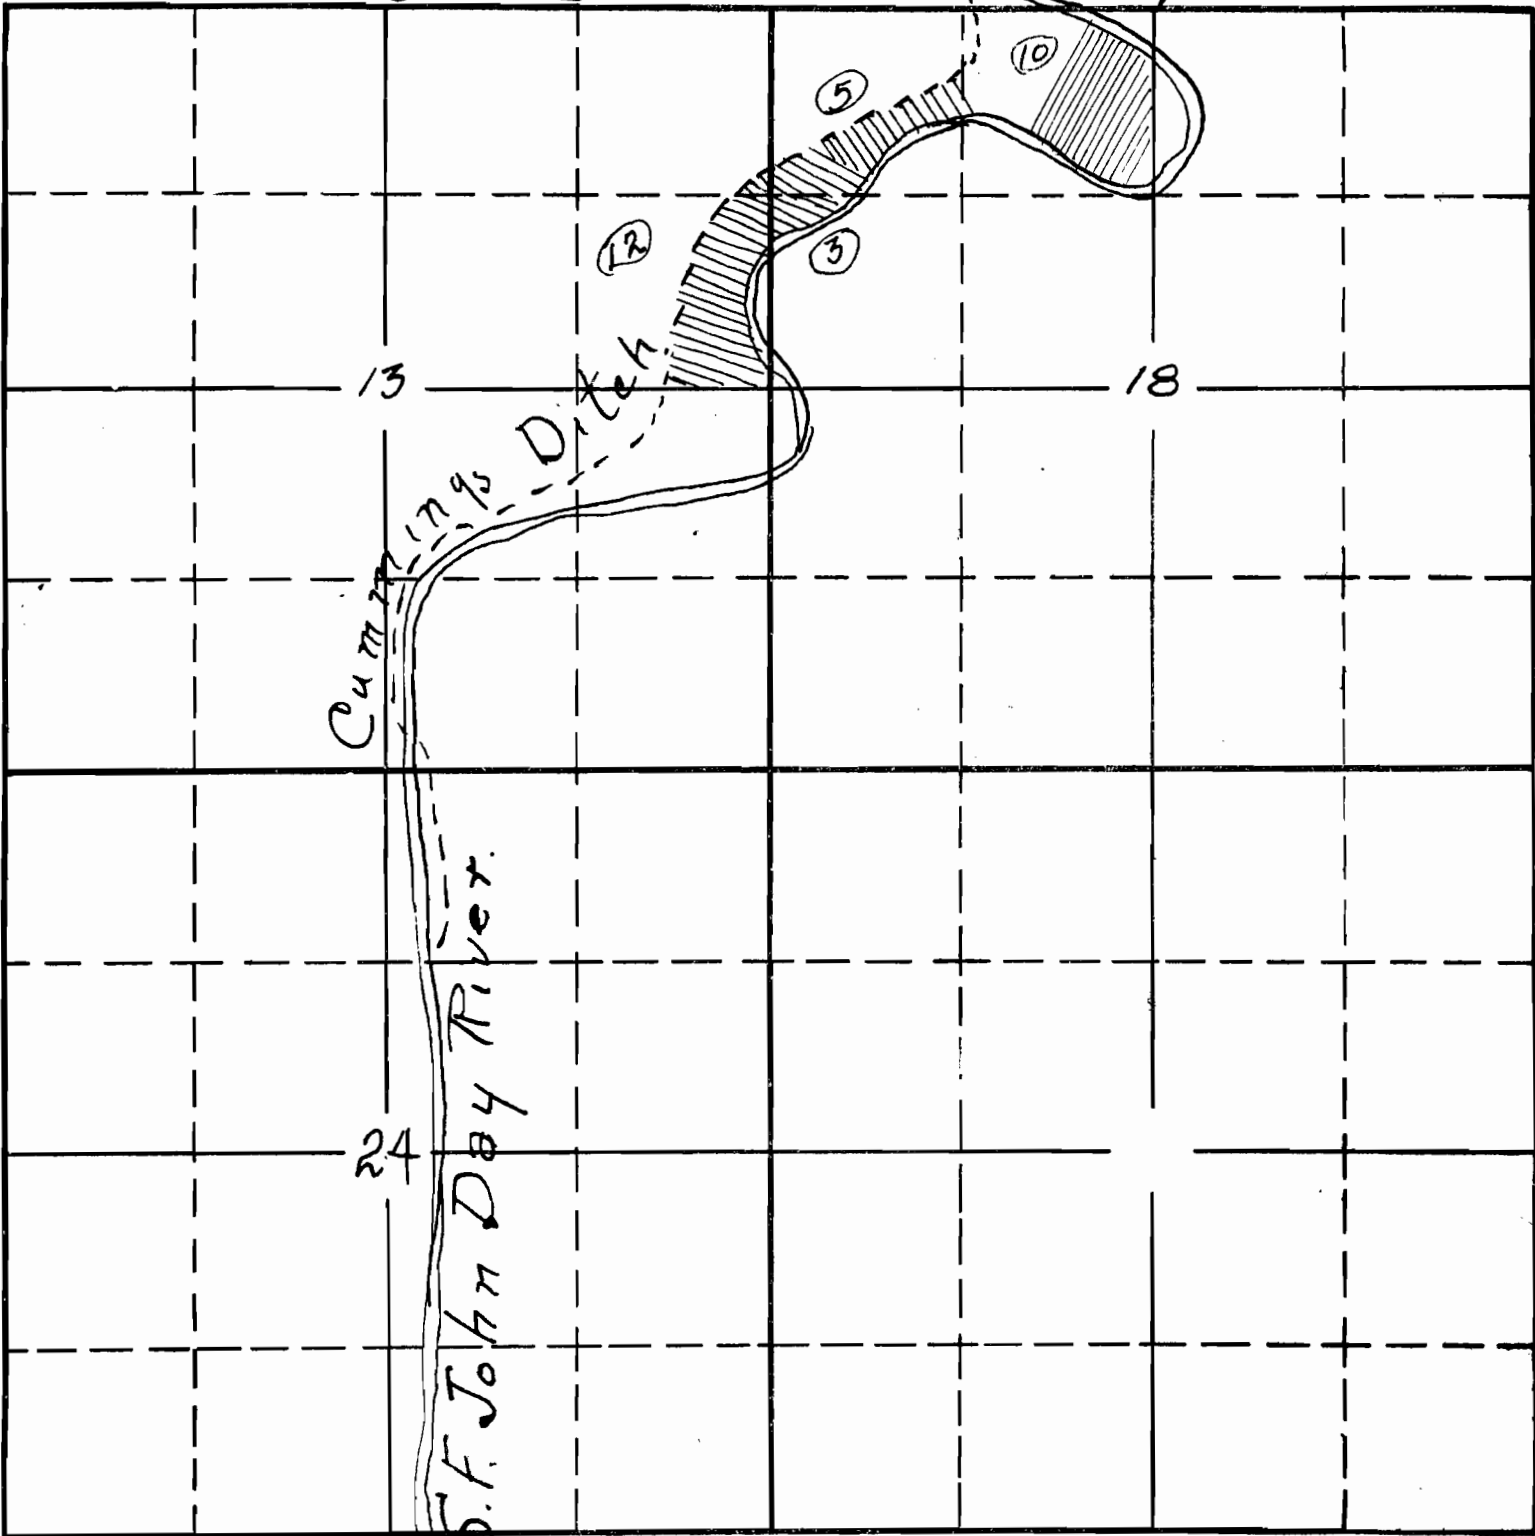

Application No. 22273  
 Permit No. 872

1/16/01