


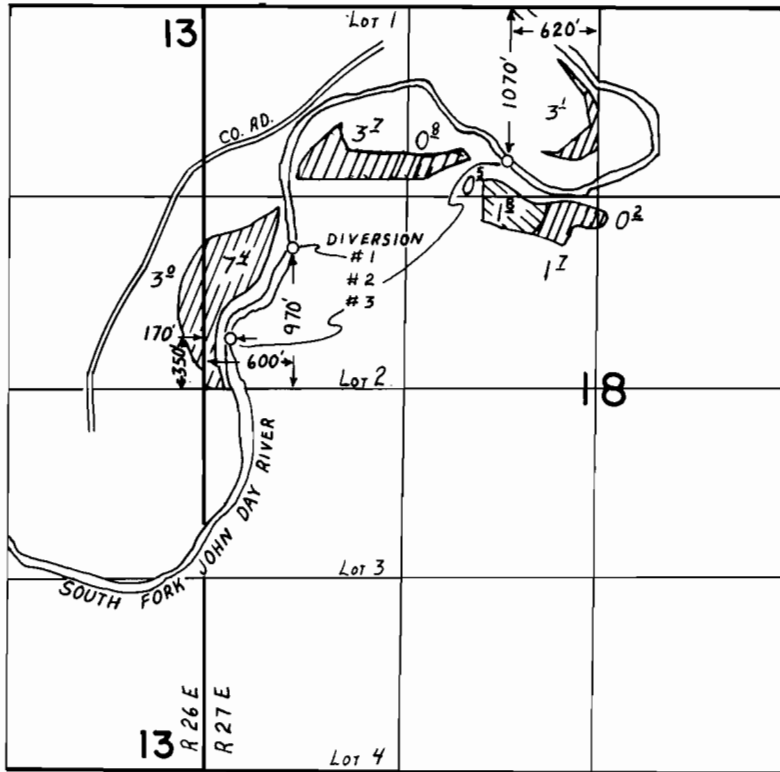

T 13 S, R 26 & 27 E, WM



SCALE:
1" = 1320'

 PRIMARY
 SUPPLEMENTAL

FINAL PROOF SURVEY UNDER

Application No. 65260 Permit No. 47898....
IN NAME OF

JAMEY MAZZOTTA

Surveyed JUNE 18, 1988, by T. M. WARREN.