


T 39 S, R 3 W, W.M.  
 Section 13  
 Jackson County, Oregon

**RECEIVED**

MAR 14 1994


WATER RESOURCES DEPT  
 SALEM, OREGON

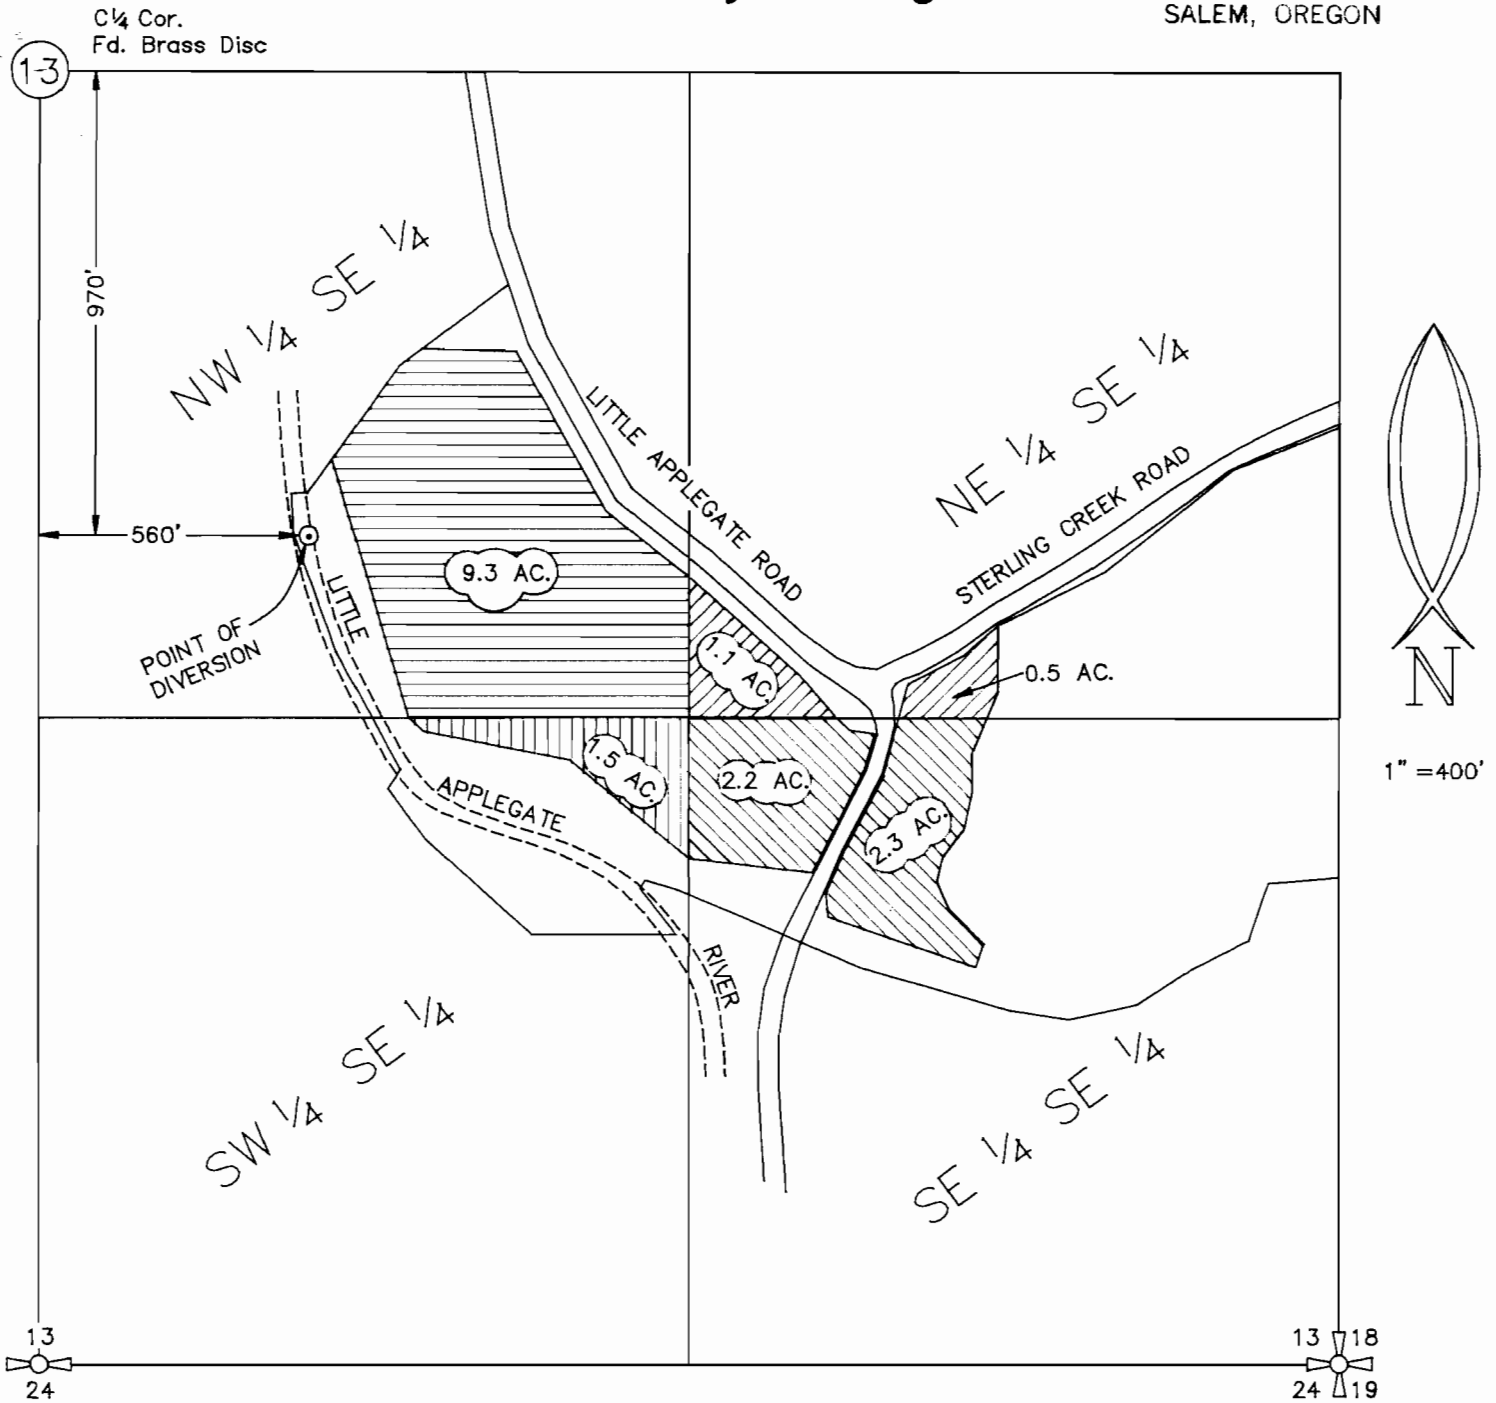

**FINAL PROOF SURVEY**  
 UNDER  
 CHANGE IN POINT OF DIVERSION

Application No. T-6539

IN THE NAME OF  
 REEVE L. HENNION

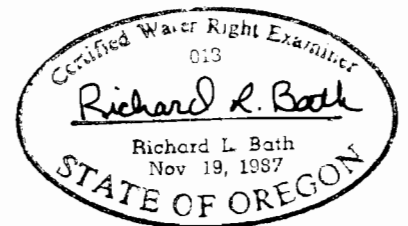

Expires 12-31-95

Surveyed Feb. 15, 1994

By Richard L. Bath  
 Richard L. Bath  
 CWRE No. 013