

RECEIVED

APR 27 2010


WATER RESOURCES DEPT

### Claim of Beneficial Use Map

Permit R-2652 ( Application R-32824)

Township 3 South, Range 6 West (W.M.)

STATE OF OREGON

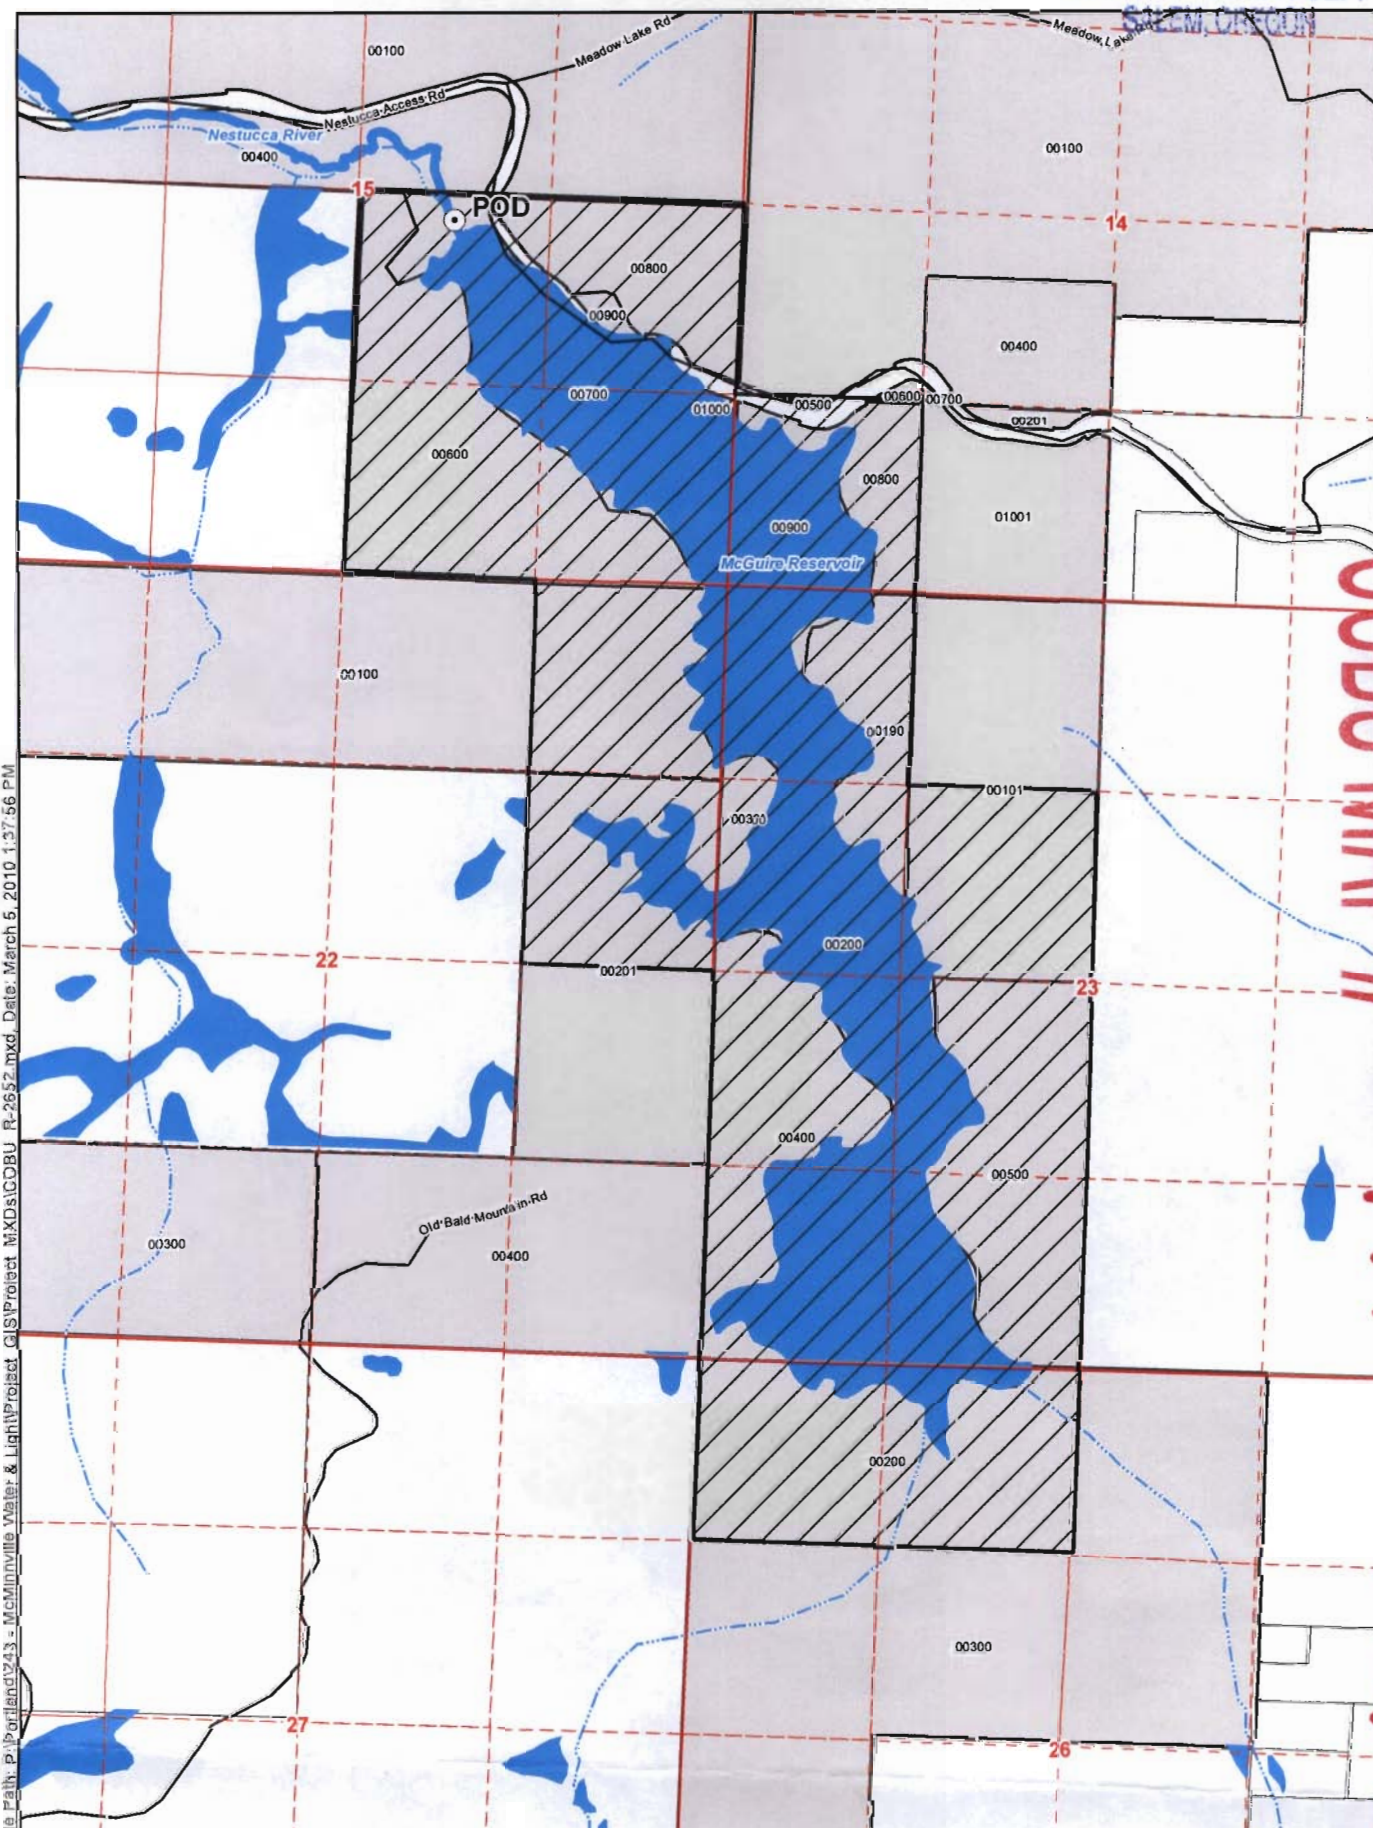

File Path: P:\Portland\243 - McMinnville water & Light\Project\_MXD\COBU R-2652.mxd Date: March 5, 2010 1:37:56 PM


COBU MAP # 04999  
1 of 2

#### Legend

- Point of Diversion (POD)
- Place of Use (POU)
- Taxlots
- Taxlots Owned by Permittee
- Streets
- Watercourses
- Waterbodies

#### POD Location Description

**POD - Center of Dam**  
 Located 2,445 feet North and 1,970 feet West  
 from the SE corner of Section 15, Township 3  
 South, Range 6 West (W.M.)

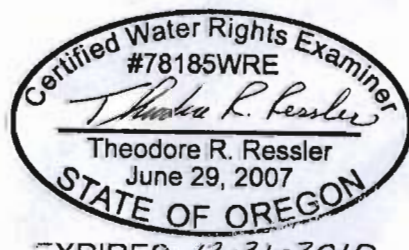

EXPIRES 12-31-2010

#### Map Information

Projection: Oregon State Plane North  
 Datum: North American Datum of 1983  
 Date: March 5, 2010  
 Prepared By: GSI Water Solutions, Inc.

**Data Sources**  
 ESRI, OWRD

#### Disclaimer

This map was prepared for the purpose of identifying the location of a water right only and it is not intended to provide legal dimensions or location of property ownership lines.



#### Scale

0 660 1,320  
 1 inch equals 1,320 feet

