

RECEIVED

APR 27 2010


WATER RESOURCES DEPT
SALEM, OREGON

Claim of Beneficial Use Map

Permit R-5561 (Application R-46563)

Township 3 South, Range 6 West (W.M.)

COBU
MAP
05000

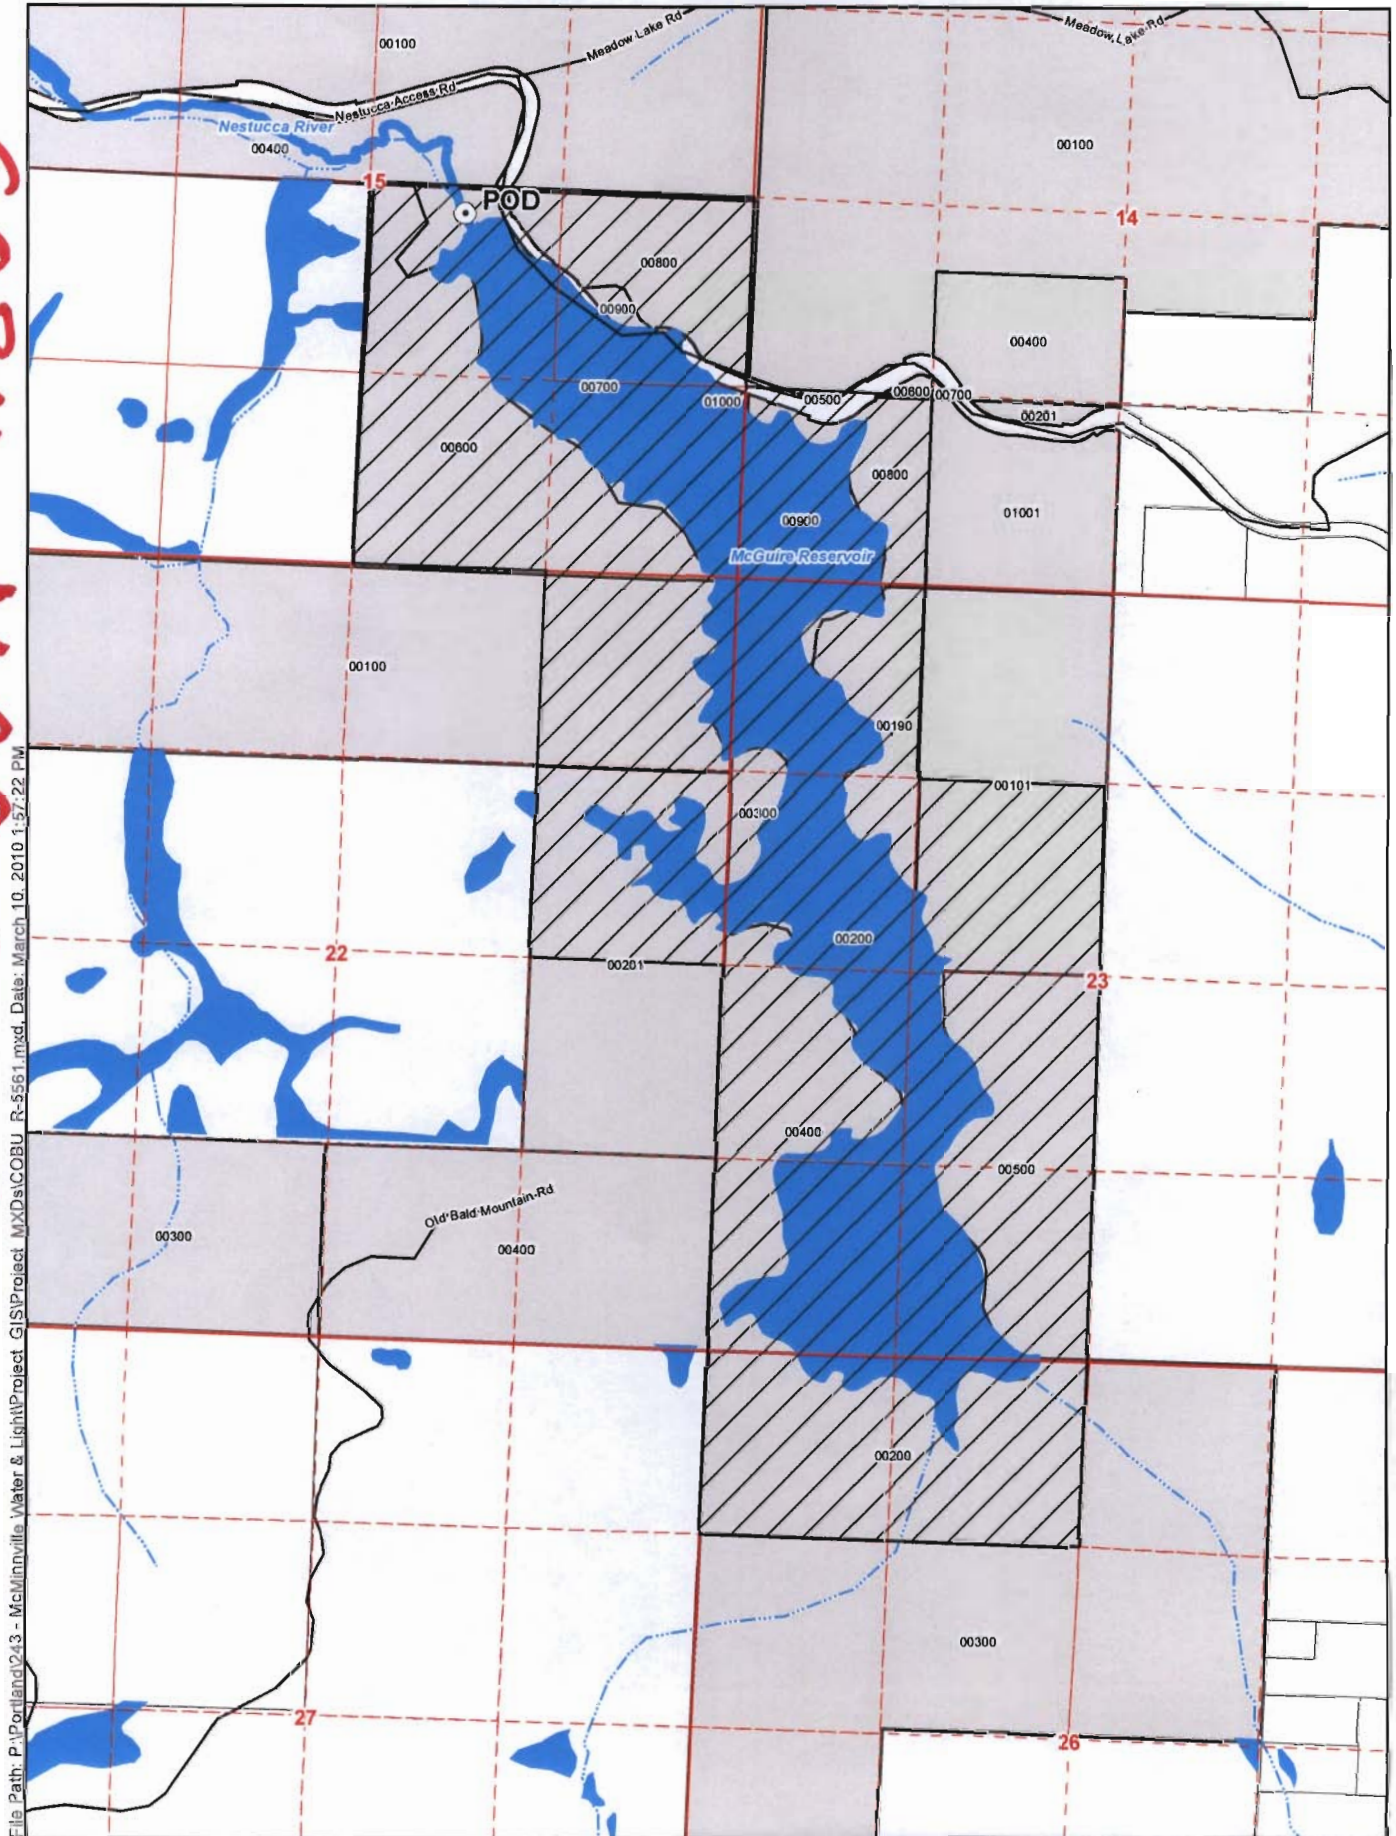

File Path: P:\Portland\243 - McMinnville Water & Light\Project_GIS\Project_MXD\COBU_R-5561.mxd, Date: March 10, 2010 1:57:22 PM

Legend

- ⊙ Point of Diversion (POD)
- ▭ Place of Use (POU)
- ⊕ Taxlots
- ⊕ Taxlots Owned by Permittee
- Streets
- ~ Watercourses
- Waterbodies

POD Location Description

POD - Center of Dam
Located 2,445 feet North and 1,970 feet West from the SE corner of Section 15, Township 3 South, Range 6 West (W.M.)



EXPIRES: 12-31-2010

Map Information

Projection: Oregon State Plane North
Datum: North American Datum of 1983
Date: March 10, 2010
Prepared By: GSI Water Solutions, Inc.

Data Sources
ESRI, OWRD

Disclaimer

This map was prepared for the purpose of identifying the location of a water right only and it is not intended to provide legal dimensions or location of property ownership lines.



Scale

0 660 1,320
1 inch equals 1,320 feet

