



T. 25 S. R. 11 W. W.M.

FINAL PROOF SURVEY
SEC. 4 NE 1/4 NW 1/4

Application No. 71977 Permit No. 51505



IN THE NAME OF

R. David & Ronda L. Amatore

Surveyed Aug. 20, 1994 by

Scale: 1" = 400'

Capacity of System = .083 CFS.

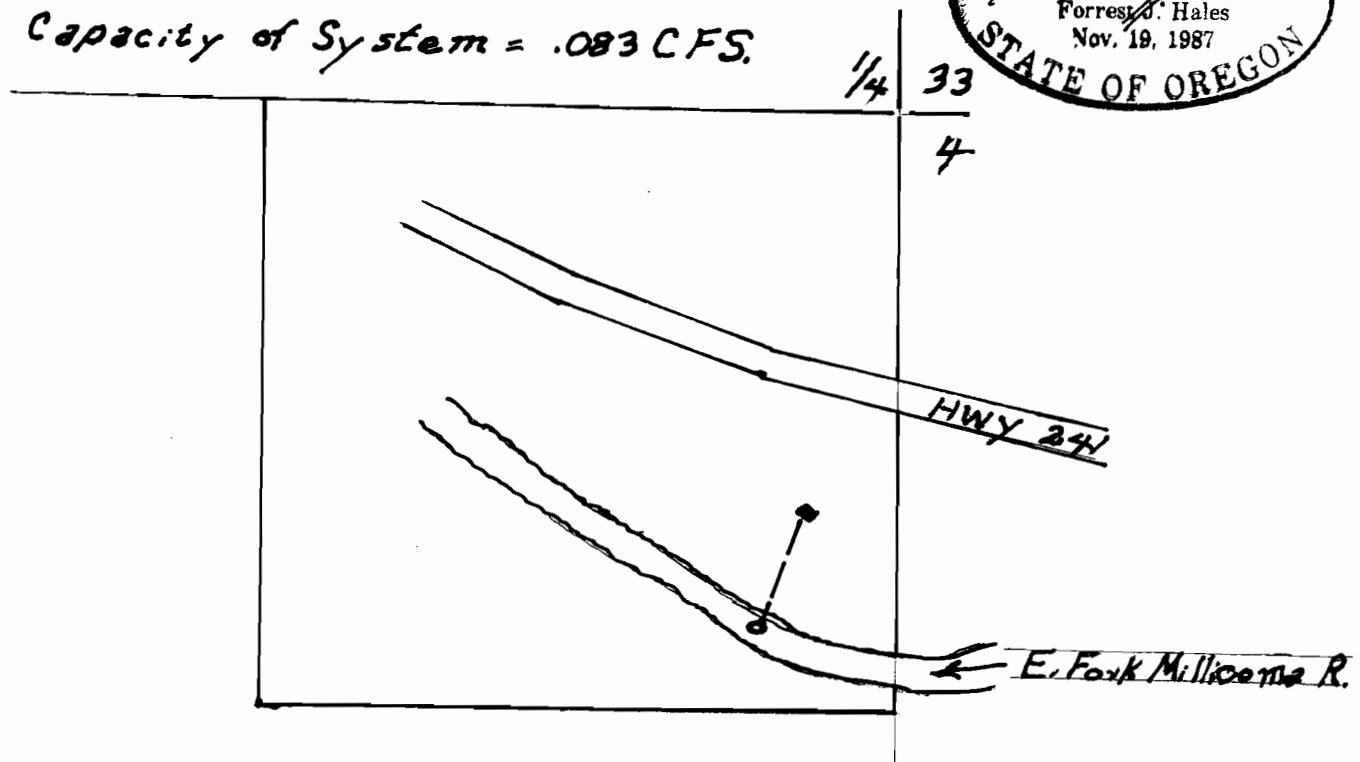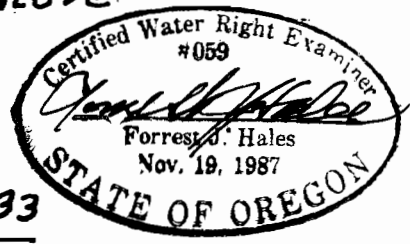

POD is 1061 ft. S + 282 ft. W.
of N. 1/4 Cor. S. 4.

OAR 690-14-170-4 ... "the map is for the purpose of identifying the location of the water right only."