


T24 S, R 32 1/2 E, WM

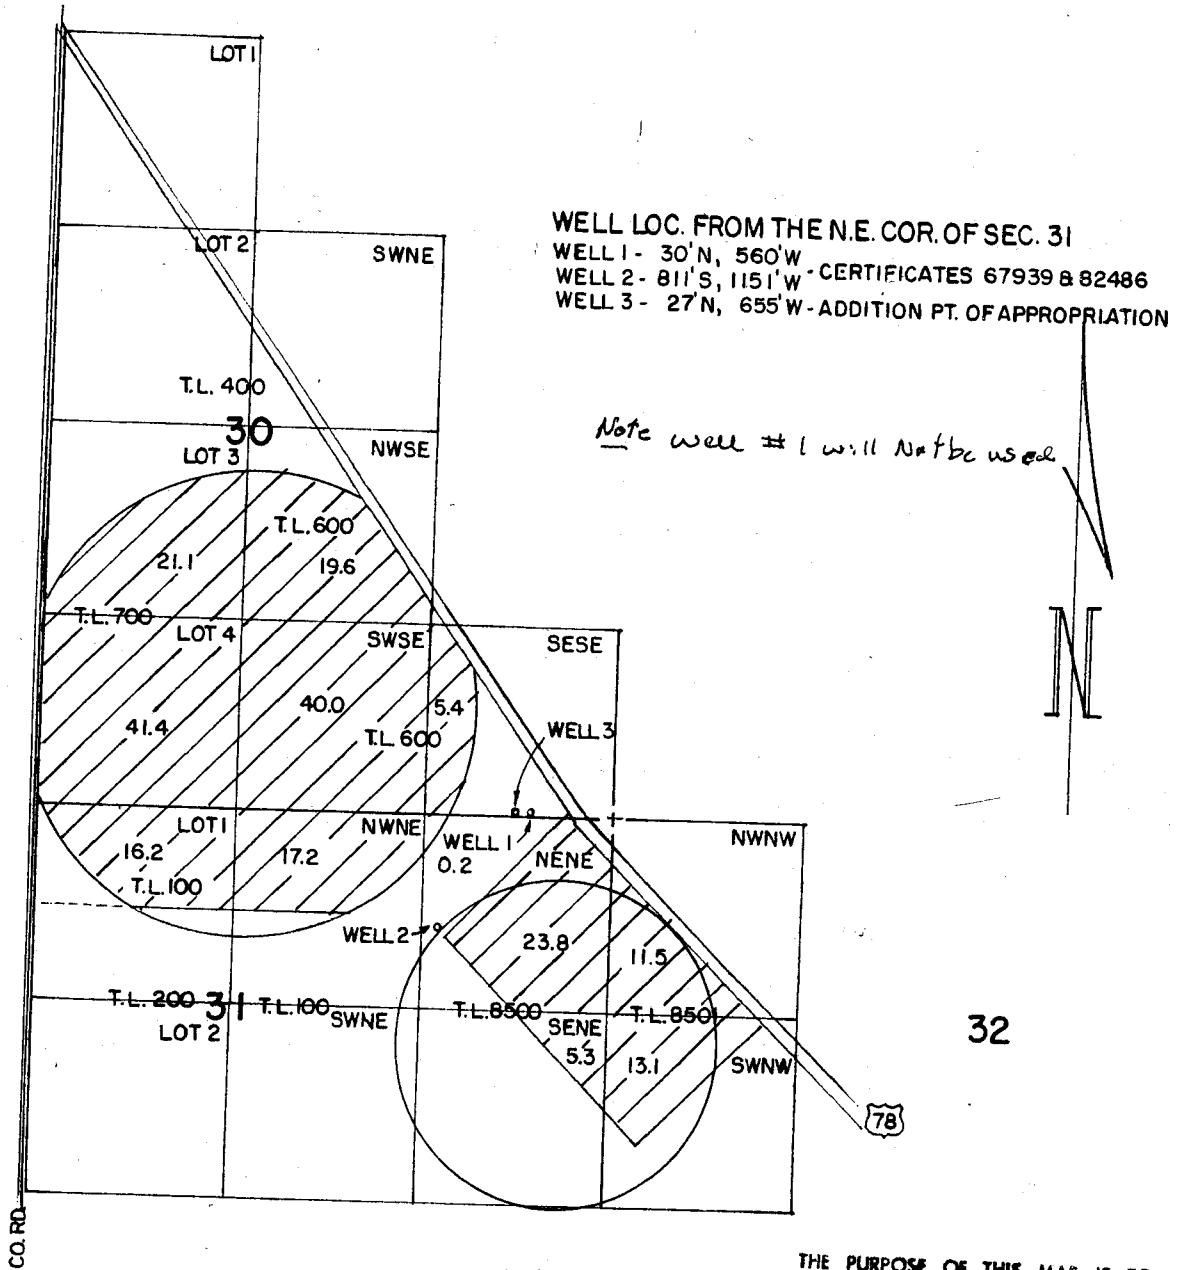

RECEIVED

JUL 25 2007

WATER RESOURCES DEPT
 SALEM, OREGON

THE PURPOSE OF THIS MAP IS TO IDENTIFY THE LOCATION OF THE WATER RIGHT. IT IS NOT INTENDED TO PROVIDE INFORMATION RELATIVE TO THE LOCATION OF PROPERTY OWNERSHIP.

JETT C. BLACKBURN

WATER RIGHT TRANSFER APPLICATION MAP

Scale: 4" = 1 MILE

Date: APRIL 2007

Job: 2406

Dsn:

Dm: CHRIS


Ckd:



M.A. PALMER & SONS, INC.
 ENGINEERING & SURVEYING
 711 Ponderosa Village • Box 81
 Burns, Oregon 97720


Sht. No.

of 1

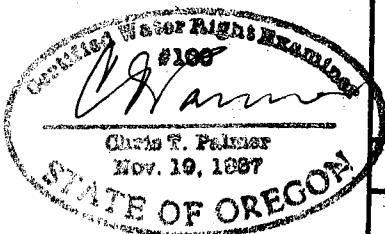

RENEW 1-1-2009

T. 24S., R. 32 1/2 E., W.M.

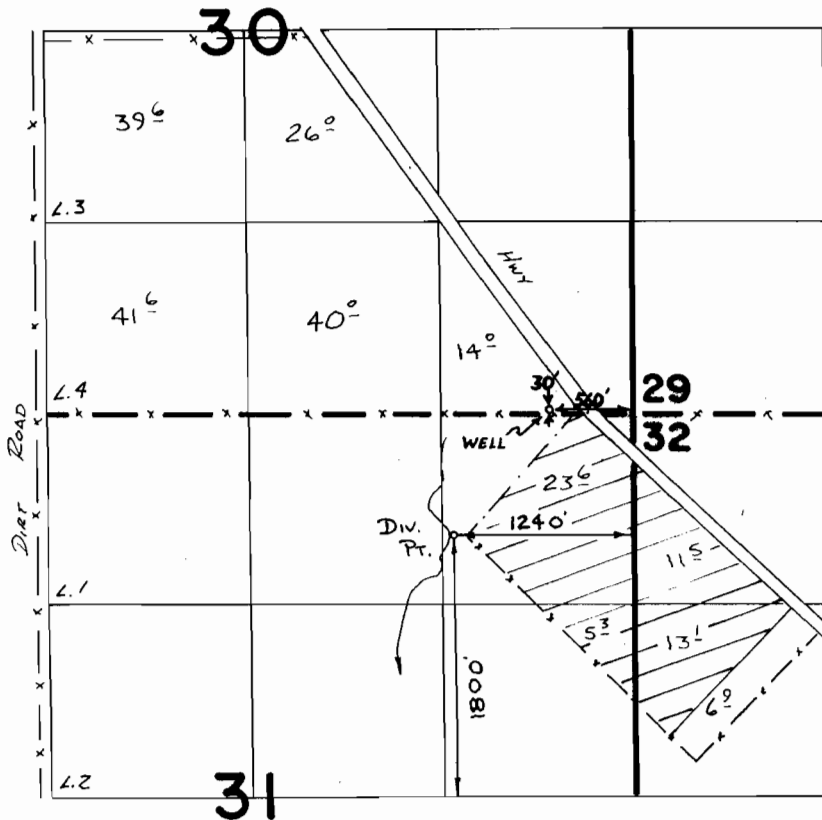

SCALE 1" = 1320'

FINAL PROOF SURVEY
UNDER

G-11378 G10512
Application No. **68368** Permit No. **49406**
IN NAME OF

.....**JAMES W. MASON, JR.**.....

Surveyed ...5-9... 1988, by *V.H. Church*.....