

CROOK COUNTY OREGON

SCALE 2" = 1 MILE

Township No. 16 S.

Range No. 24 E.

Range No. 25 E.

I, R. L. Brewster of Prineville Ore, do hereby certify that this map was made from an actual survey made by me in June 1913, and that it correctly represents the works described in the accompanying application, together with the location of streams and other ditches, and has written thereon the area in each smallest legal subdivision which it is proposed to irrigate

R. L. Brewster
Surveyor

CLERK OF STATE RECEIVED

RECEIVED


JUL 9 1913

SALEM, - OREGON,

APPLICATION No. 3074

Permit No. 1711

p 1711

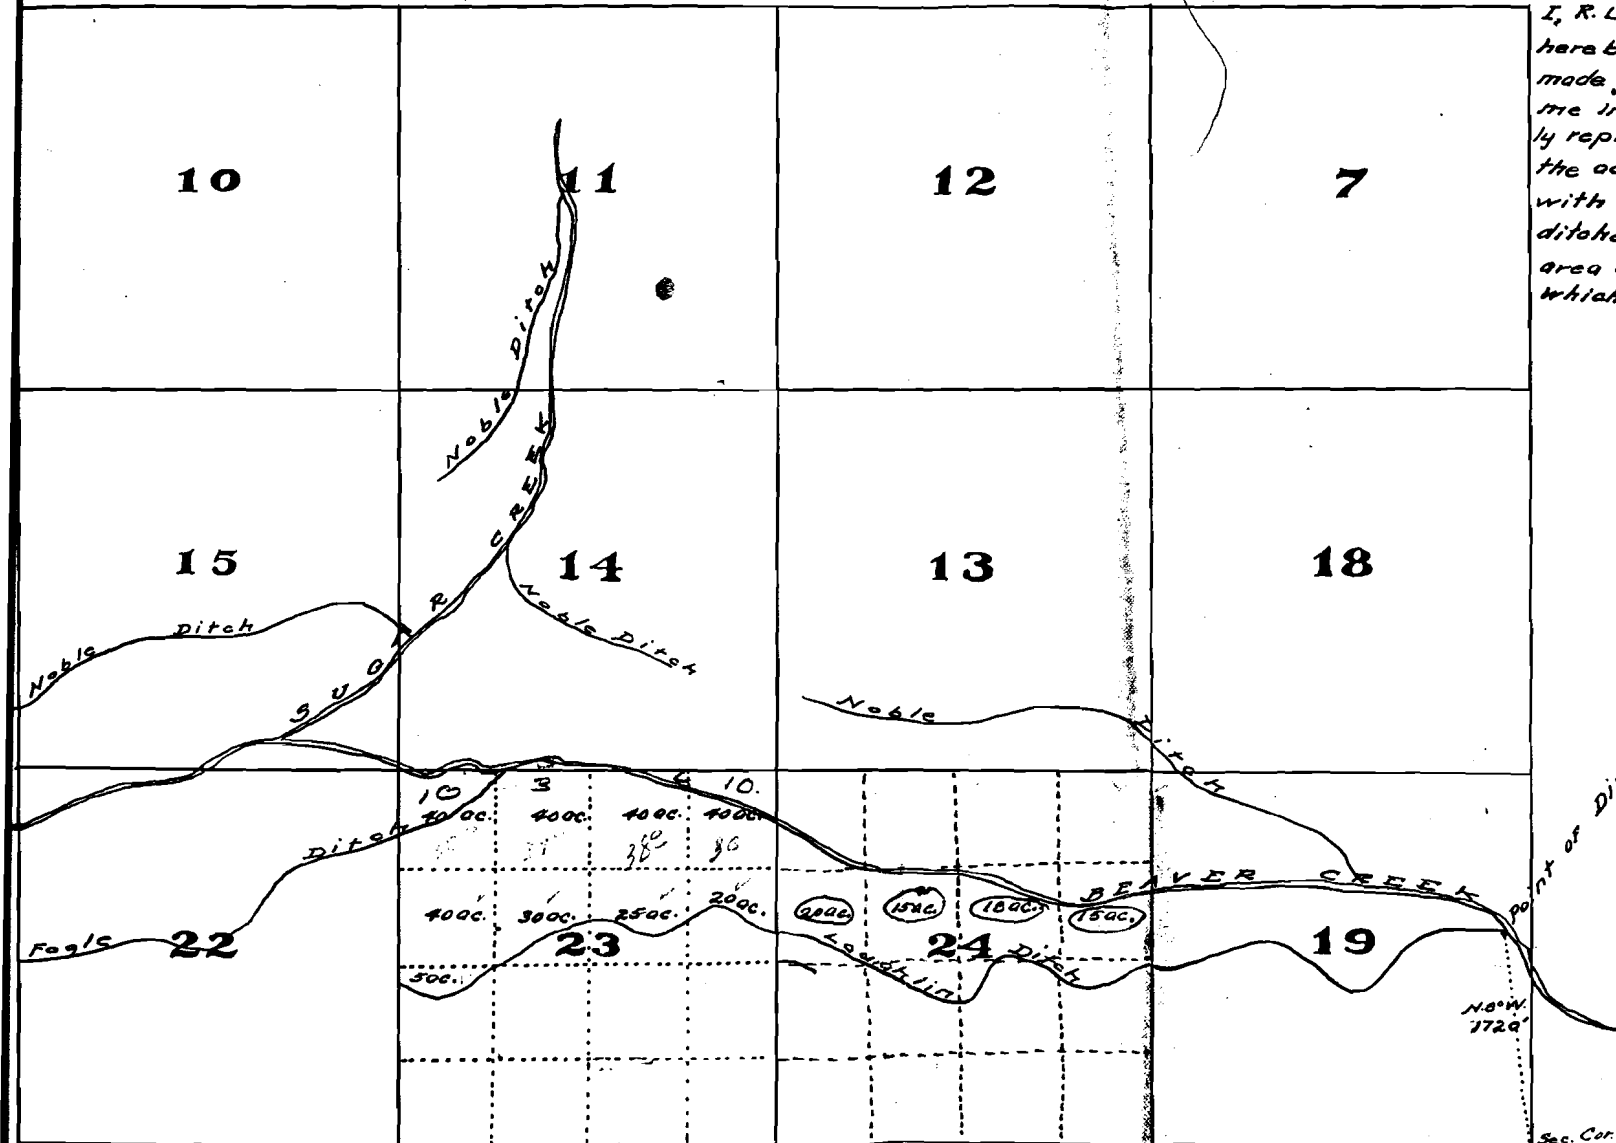

Area shown  thus allowed G. W. Noble by deprec.