


T.39S., R.18E., W.M.

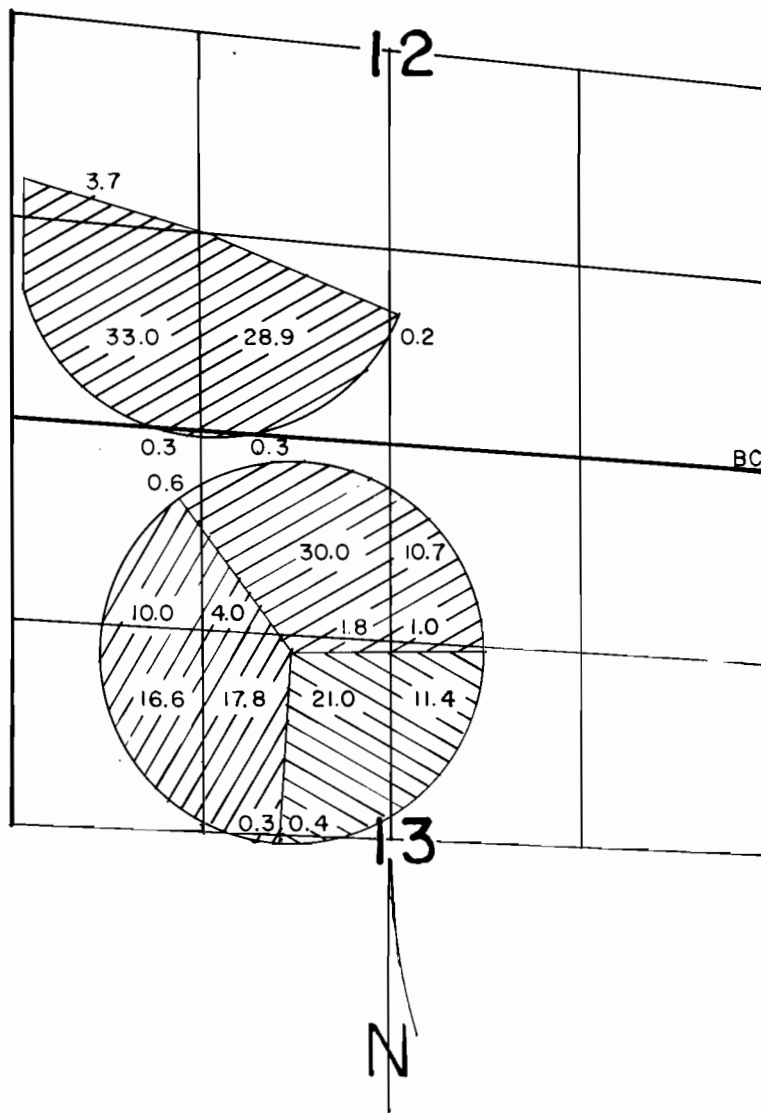

SCALE 1" = 1320'

# FINAL PROOF SURVEY

UNDER

5729

5730

TRANSFER NO. 5731

IN NAME OF

**CHARLES KELLEY**

Surveyed OCT. 19... 1987., by M.J. MATTICK.....  
JUN 22 1984 B.W. BISHOP