


T.39S., R.18E., W.M.

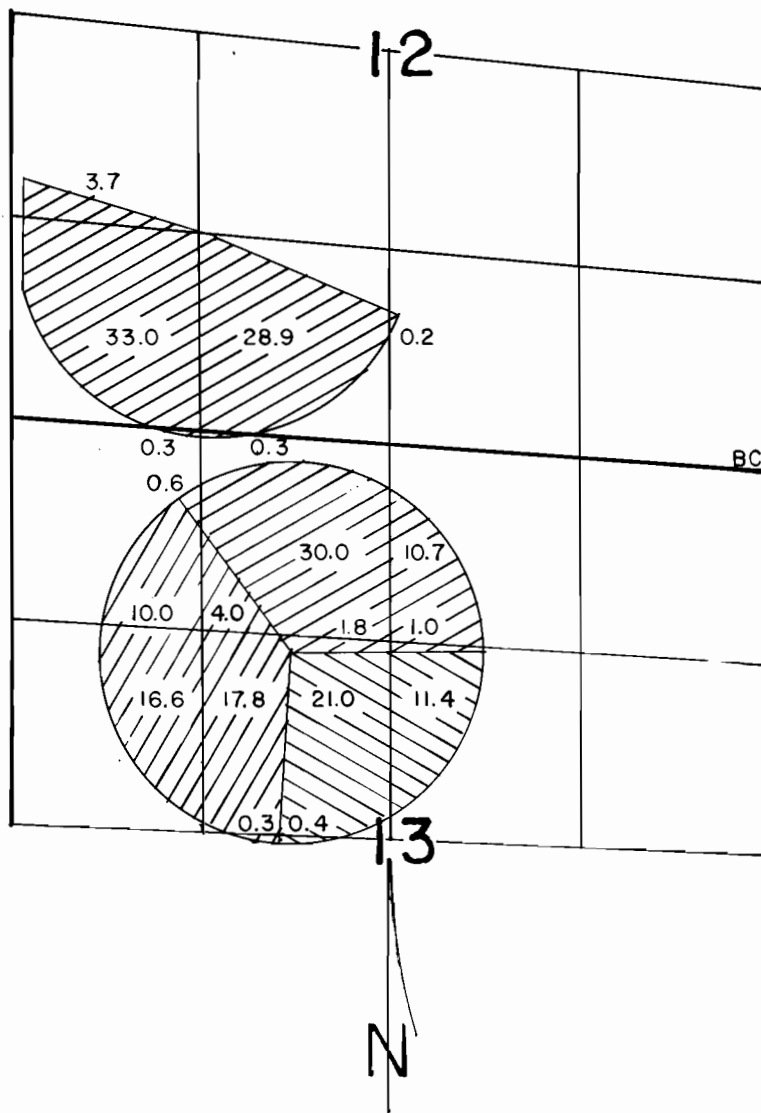

SCALE 1" = 1320'

FINAL PROOF SURVEY

UNDER

5729
5730

TRANSFER NO. 5731
IN NAME OF



CHARLES KELLEY

Surveyed OCT. 19... 1987., by M.J. MATTICK.....
JUN 22 1984 B.W. BISHOP