


T.1 S. R.4 E. W.M.

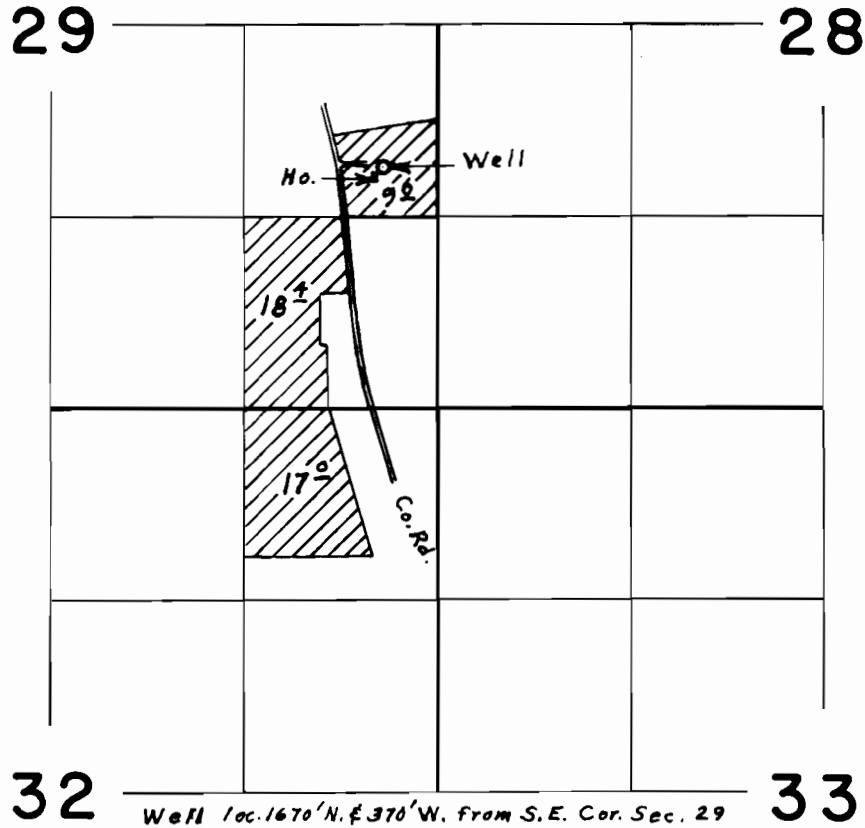

FINAL PROOF SURVEY
UNDER

Application No. G-6107 Permit No. G-5784
IN NAME OF

JAMES R. BUSHUE

Surveyed Oct. 6, 1976, by L. E. Gould