


26

S.E. $\frac{1}{4}$ of N.E. $\frac{1}{4}$
SEC. 26

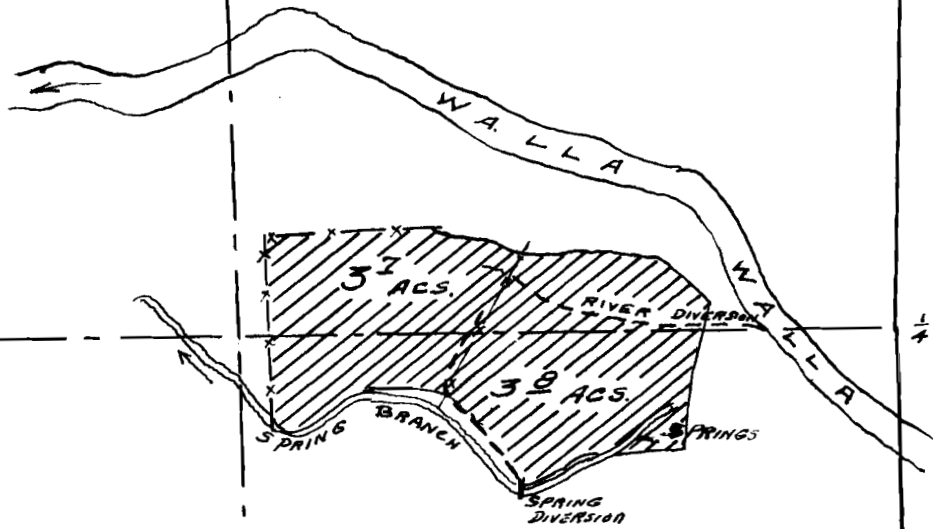

N.E. $\frac{1}{4}$ of S.E. $\frac{1}{4}$
SEC. 26
T. 5 N. 36 E.



MAP TO ACCOMPANY
FINAL PROOF - PERMIT
8274 - GEORGE HARRIS SR.