

FINAL PROOF SURVEY

UNDER

TRANSFER No. 7213 OF CERTIFICATE No. 61707

for: JAMES FREDERIC

SECTION 36, T. 13 S., R. 2 E., W. M.

SCALE: 1" = 400'

SURVEYED SEPT. 21, 1995, BY ARNOLD BRUBAKER


RECEIVED

NOV 13 1995

WATER RESOURCES DEPT.
SALEM, OREGON



THE PURPOSE OF THIS MAP IS TO IDENTIFY THE LOCATION OF THE NEW DIVERSION POINT, IT IS NOT INTENDED TO PROVIDE INFORMATION RELATIVE TO THE LOCATION OF PROPERTY OWNERSHIP BOUNDARY LINES.

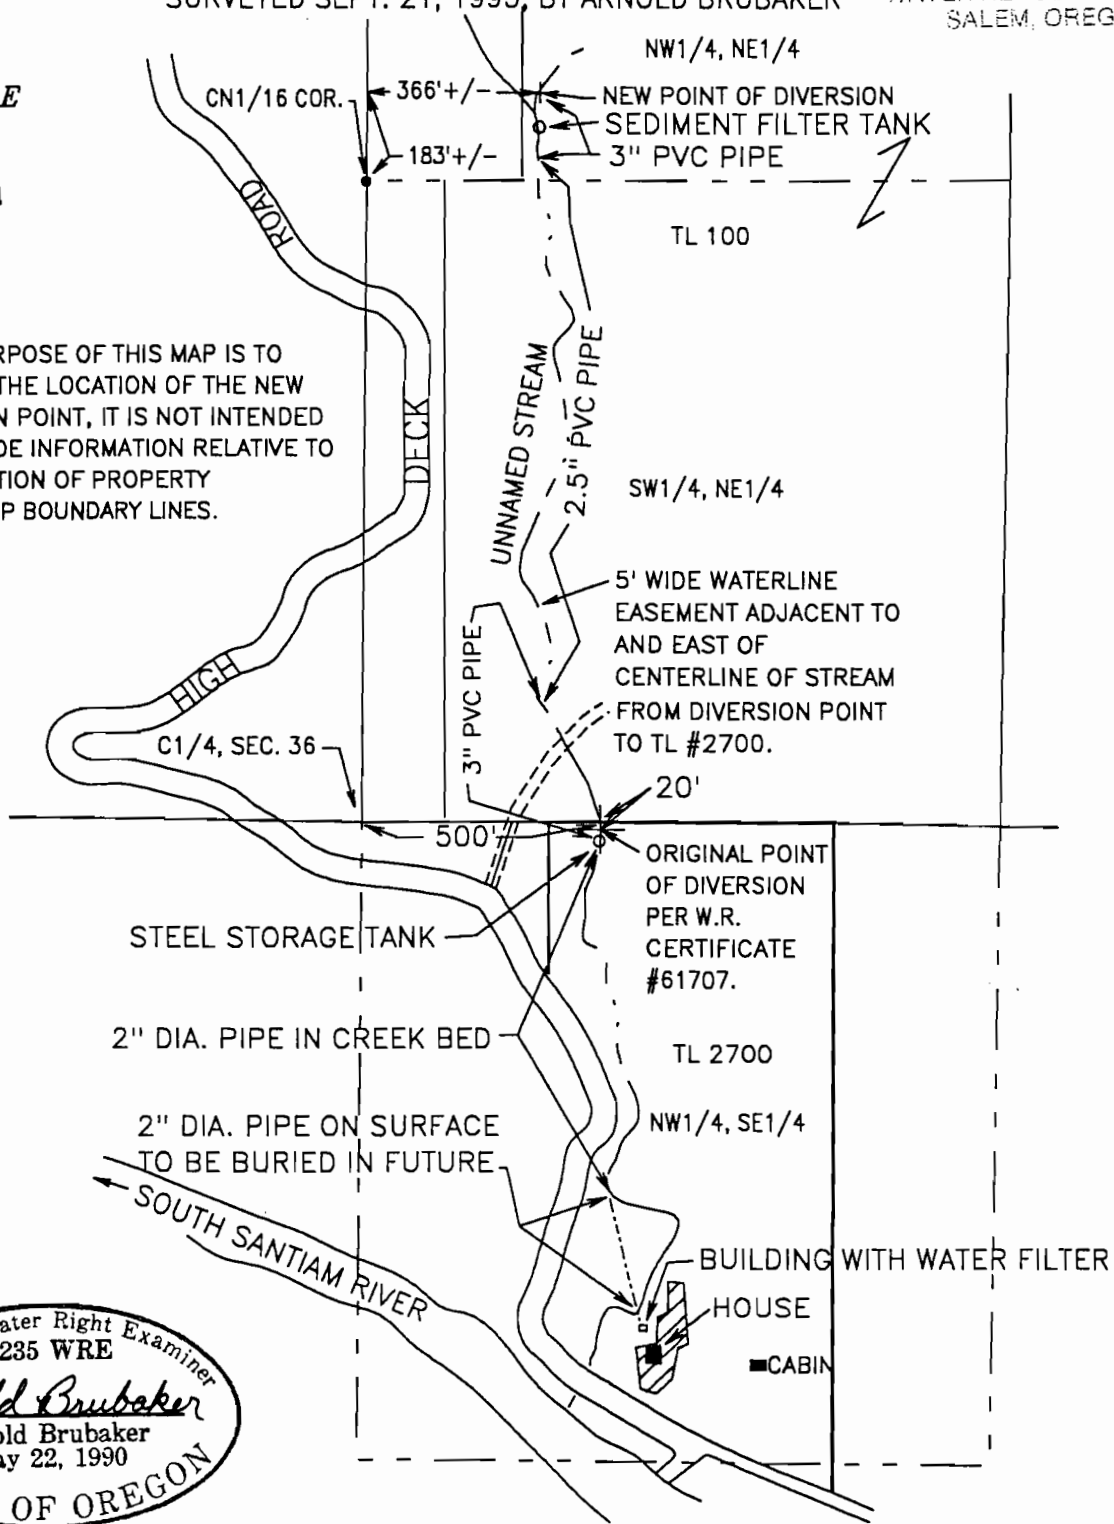

Certified Water Right Examiner
#235 WRE
Arnold Brubaker
Arnold Brubaker
May 22, 1990
STATE OF OREGON