


# T.7S., R4W., W.M.

RECEIVED

JUL 15 1994

WATER RESOURCES DEPT.  
SALEM, OREGON

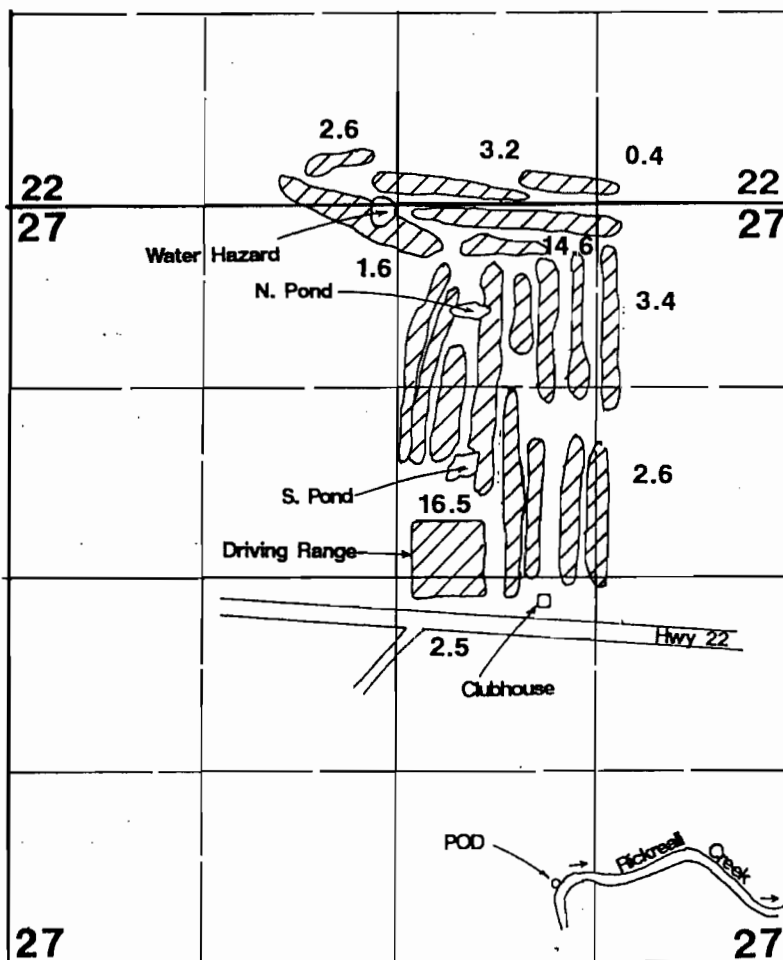

Area Irrigated  
w/in DLC 50  
DC WRD  
7/7/2016

POD located 520'N & 1600'W from SE corner Section 27.


## Final Proof Survey

Transfer #: T-6231

In Name Of

## Oak Knoll Golf Course

Surveyed on August 24, 1993 by J Grimm  
(Revised 7-15-94)

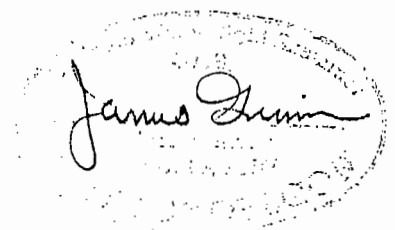

THIS MAP WAS PREPARED FOR THE PURPOSE OF IDENTIFYING THE LOCATION OF A WATER RIGHT ONLY AND IS NOT INTENDED TO PROVIDE LEGAL DIMENSIONS OR LOCATION OF PROPERTY OWNERSHIP LINES.