

T5N, R35E, WM
Sections 3, 4, 5, 8, 9, 10
T6N, R35E, WM
Sections 31 and 32
UMATILLA COUNTY

Points of Appropriation

POA 3A: 1156 ft N and 314 ft E from S/4 Corner of Section 3. Flowmeter in same location. Well Log UMAT 55526.
POA 4A: 415 ft S and 500 ft W from Center of Section 4. Flowmeter in same location. Well Log UMAT 55523.

POA 4D: 375 ft S and 940 ft W from Center of Section 4. Flowmeter in same location. Well Log UMAT 56382.
POA 50516: 930 ft S and 1355 ft E from NW Corner of Section 4. Flowmeter in same location. Well Log UMAT 50516.


Conveyance

Conveyance system is buried pressure pipeline ranging in size from 6 to 15 inches in diameter. Water applied for irrigation of various crops with variety of sprinkler and drip irrigation systems.

Place of Use



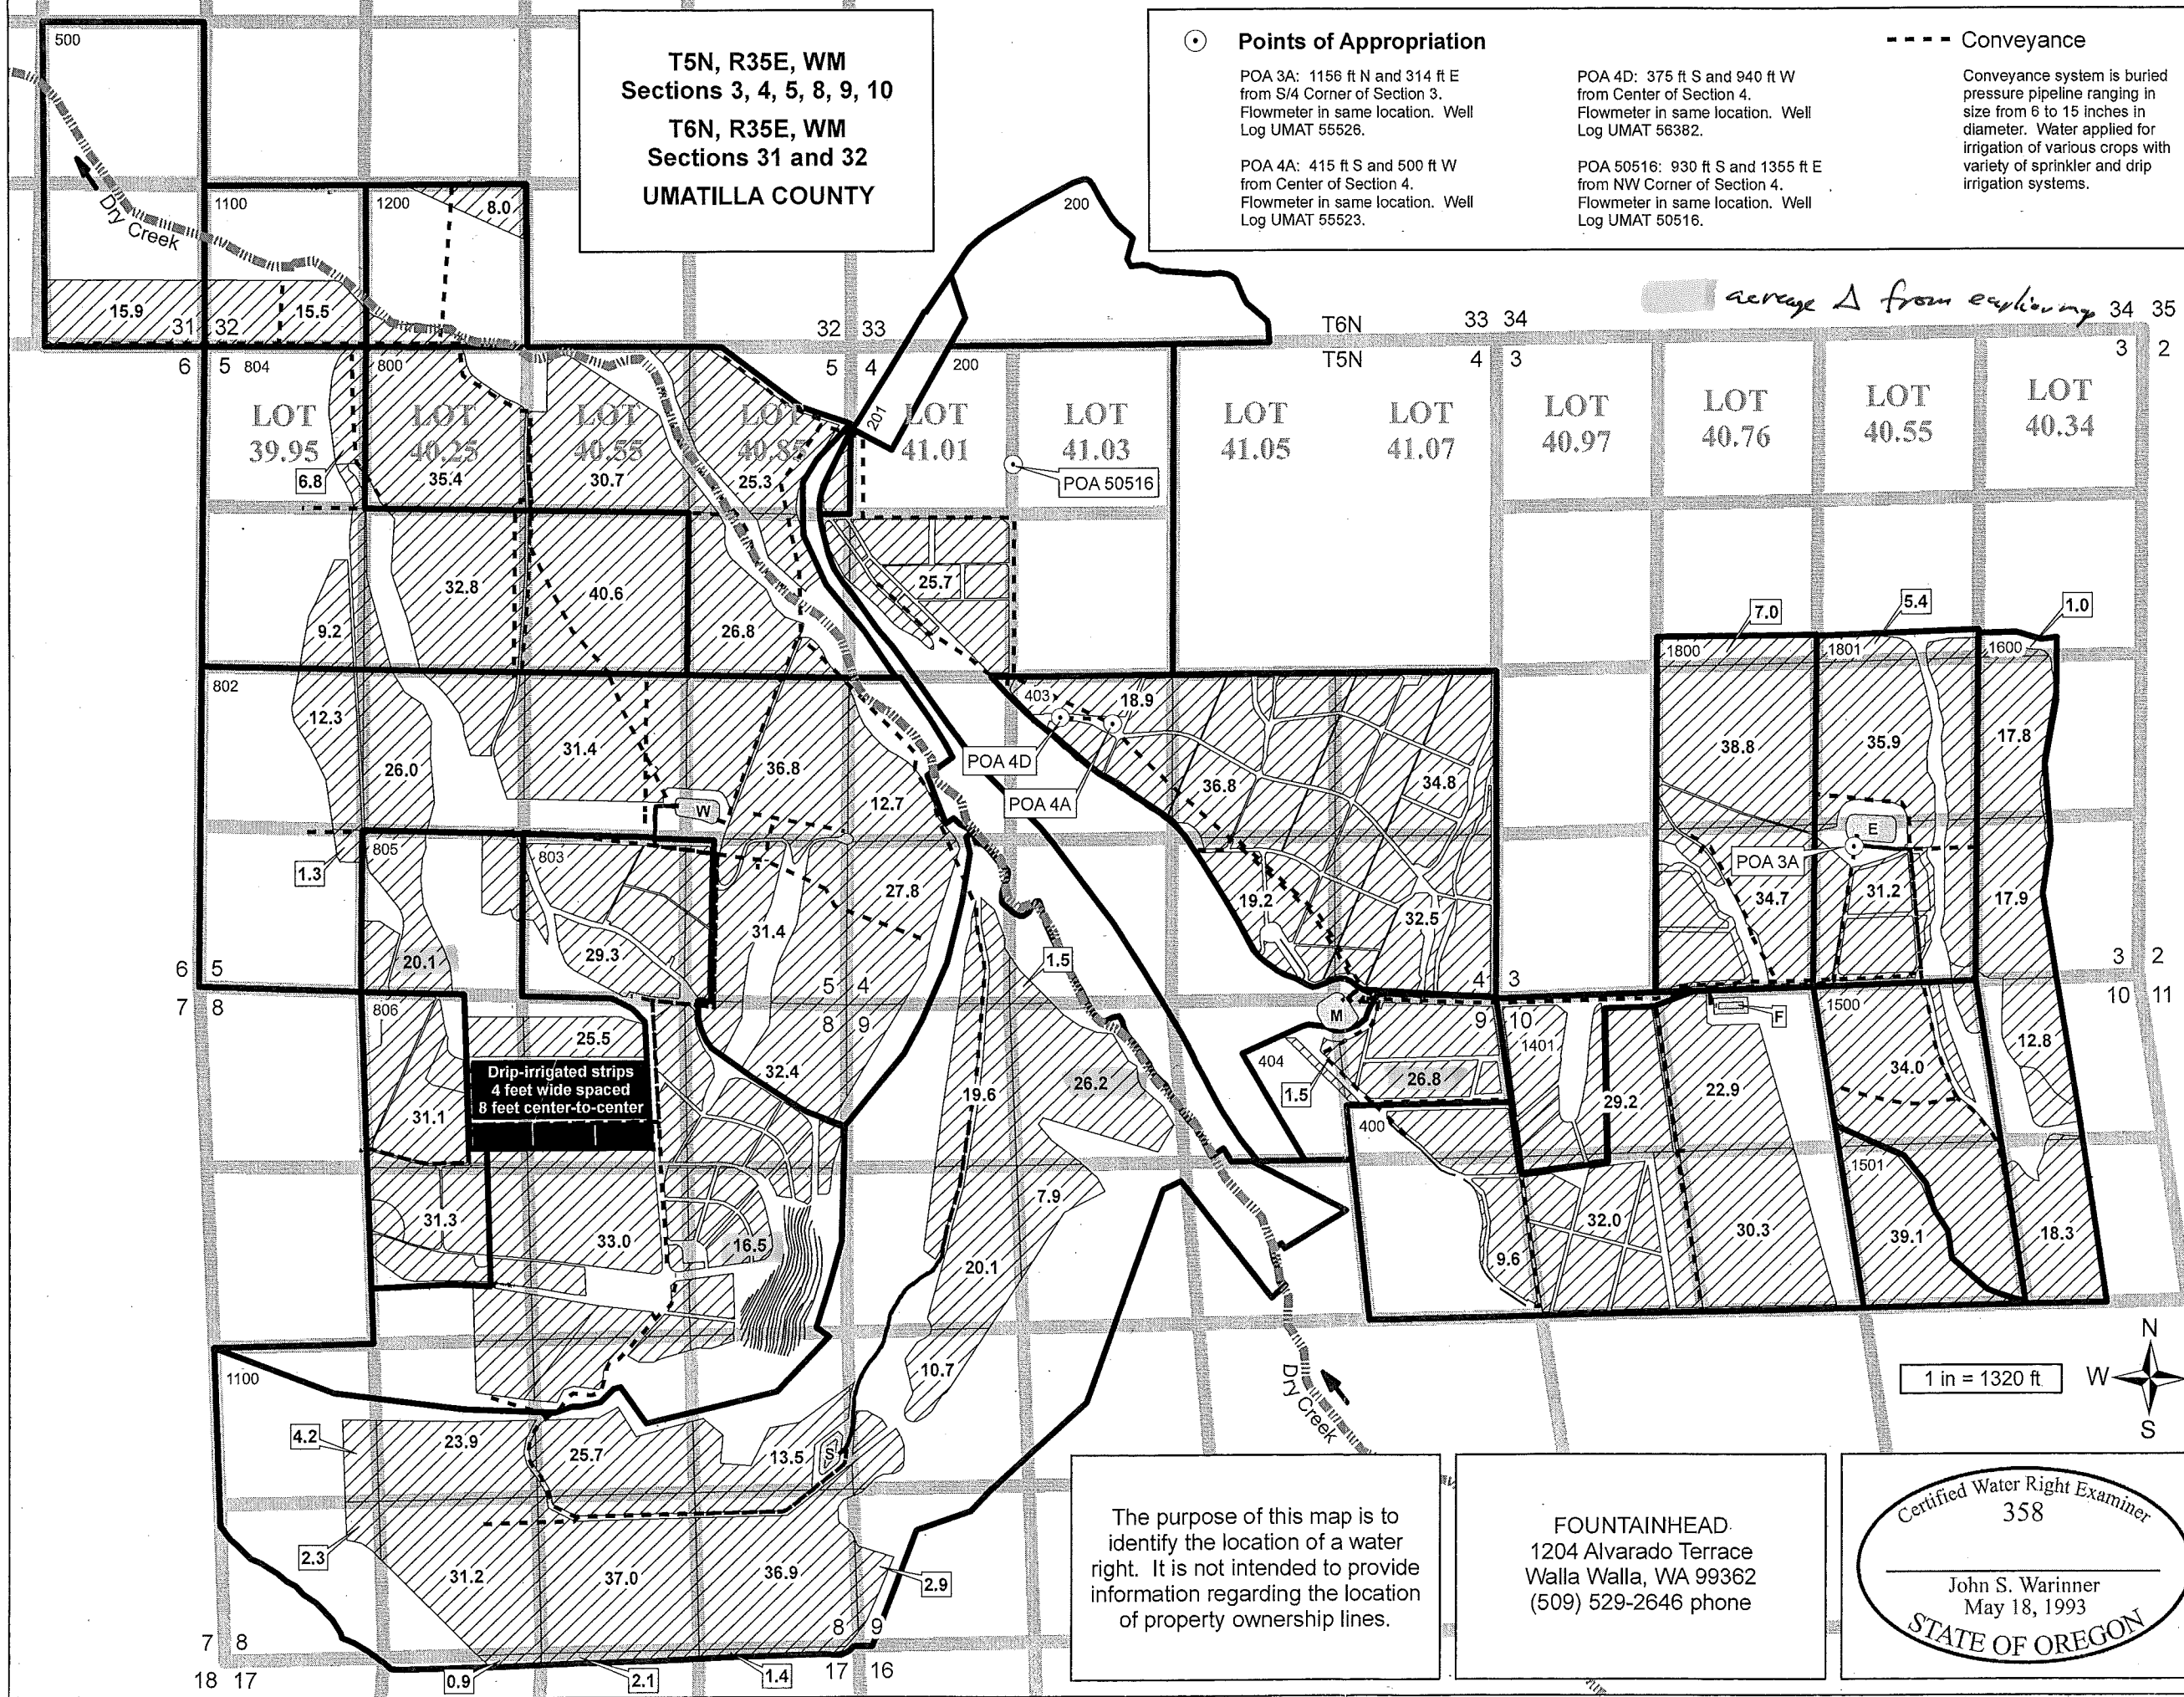

The purpose of this map is to identify the location of a water right. It is not intended to provide information regarding the location of property ownership lines.

FOUNTAINHEAD
1204 Alvarado Terrace
Walla Walla, WA 99362
(509) 529-2646 phone

Certified Water Right Examiner
358
John S. Warinner
May 18, 1993
STATE OF OREGON

CLAIM OF BENEFICIAL USE MAP
Application G-16322
Permit G-15883
Permit Amendment T-10777
in the name of
SEVEN HILLS PROPERTIES, LLC
Revised: 24 MAY 2010