


T. 38 S., R. 19 E., W.M.

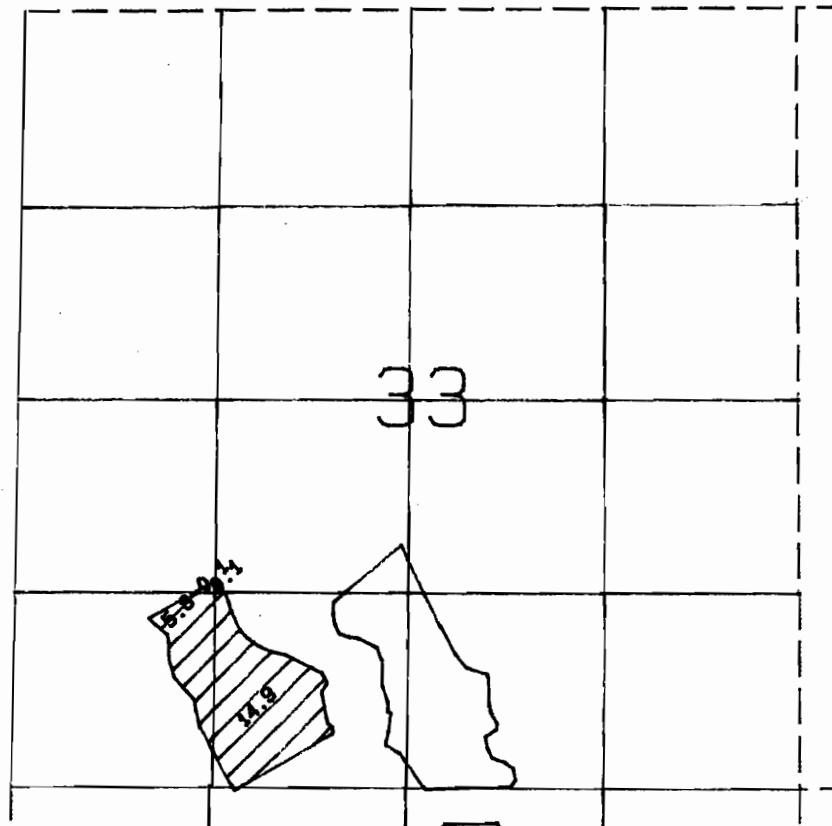

SCALE: 1 = 1320

FINAL PROOF SURVEY

UNDER

Transfer No. 4477

IN NAME OF

COTTONWOOD CATTLE COMPANY

Surveyed Oct. 16, 1987 By M. J. MATTICK

Photo: 379-100C LN