

Ferguson Surveying



Engineering




P.O. BOX 519, 210 E. MAIN
MT. VERNON, OR 97865
PHONE (541)932-4520
FAX (541)932-4430
EMAIL dfsc@oretelco.net

CUTSFORTH PARK POND LOCATION MAP

April 6, 2010

Application No. R-87536
Permit No. R-14824
Applicant Name: County of Morrow

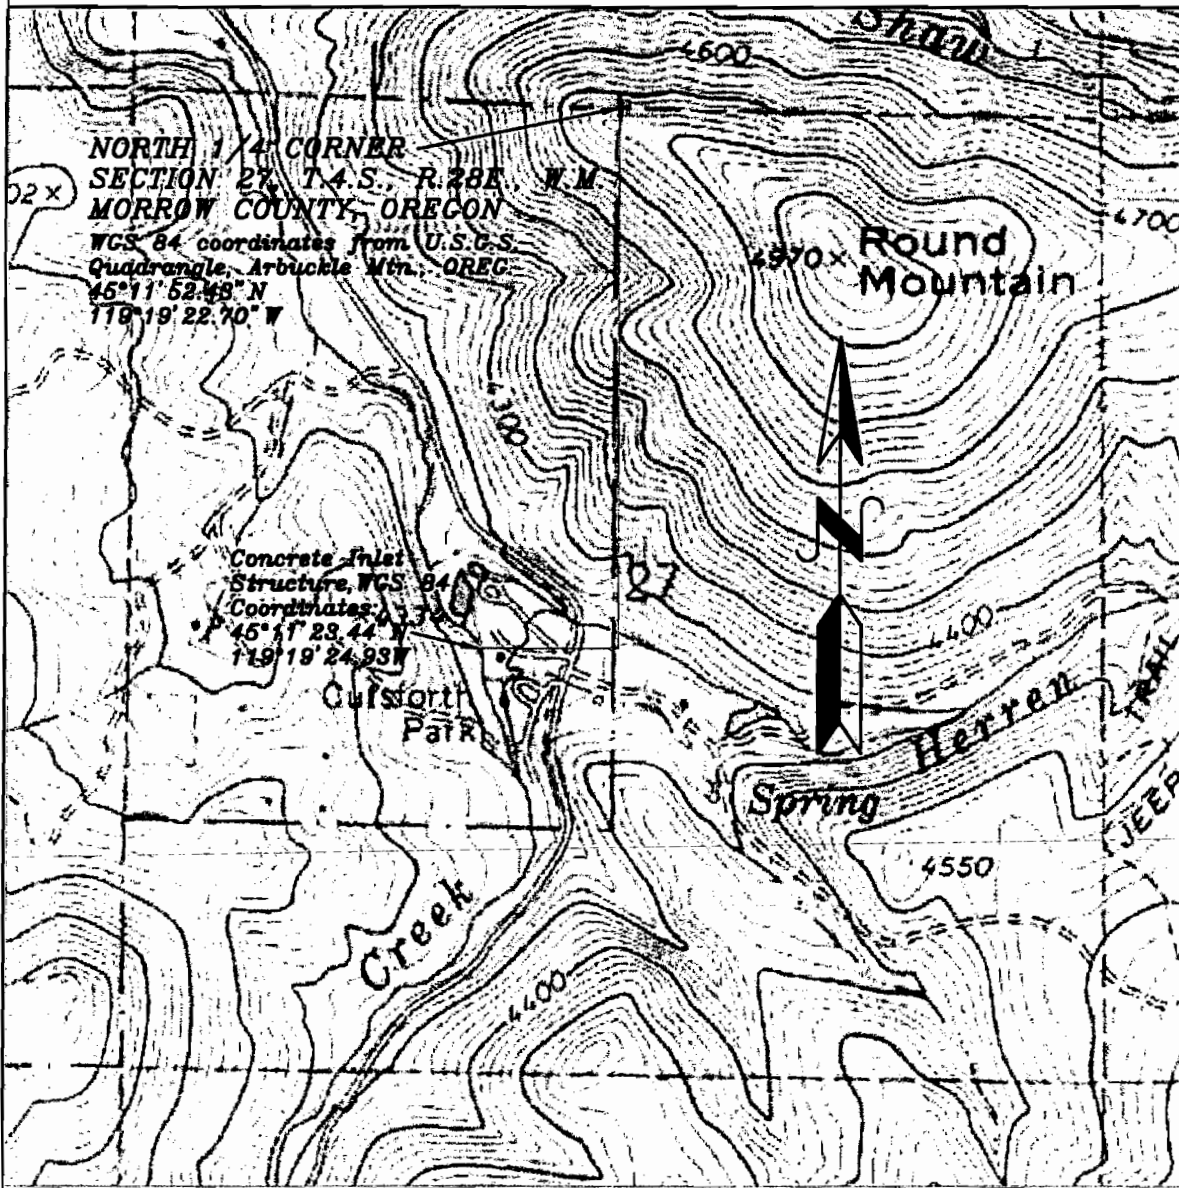

A PORTION OF
U.S.G.S. QUADRANGLE
Arbuckle Mtn., OREG.
Scale 1" = 1000'

RECEIVED

APR 19 2010

WATER RESOURCES DEPT
SALEM, OREGON