


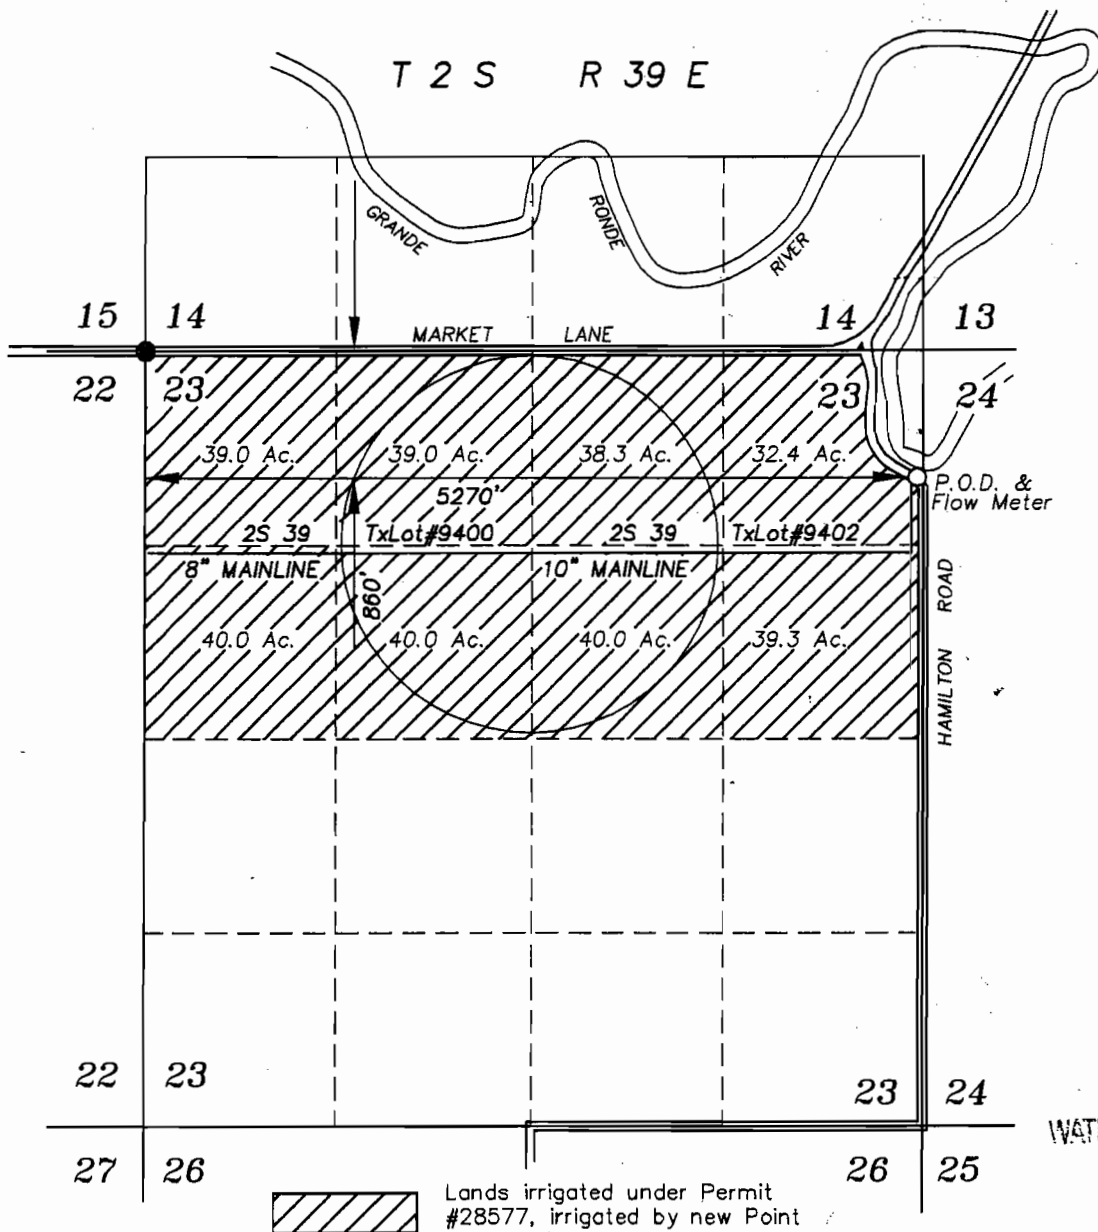

RECEIVED

APR 21 2010

WATER RESOURCES DEPT
SALEM, OREGON

APRIL 15, 2010.


FINAL PROOF MAP FOR CHANGE OF POINT OF DIVERSION

FOR

ANN ORCUTT

BAGETT-GRIFFITH & BLACKMAN
2006 ADAMS AVENUE
LAGRANDE, OREGON 97850

Application No. T-9773
Permit Number T-9773

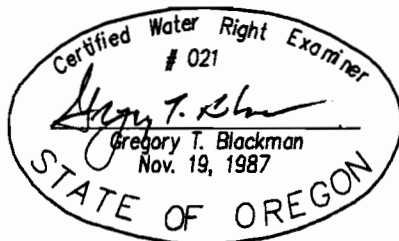

NOTE: The preparation of this map was for the purpose of identifying the location of water rights and has no intent to provide dimensions of location of property ownership lines. Location information shown hereon was furnished by the applicant.