

NOTE: THIS MAP IS THE LOCATION OF WATER RIGHTS AND IS NOT
TO PROVIDE LEGAL DIMENSIONS OR LOCATION OF PROPERTY LINES.


REF

SEP 28 1995


T. 18 S., R. 5 W., W.M.

WATER RESOURCES DEPT.
SALEM, OREGON

SCALE : 1"=1000'

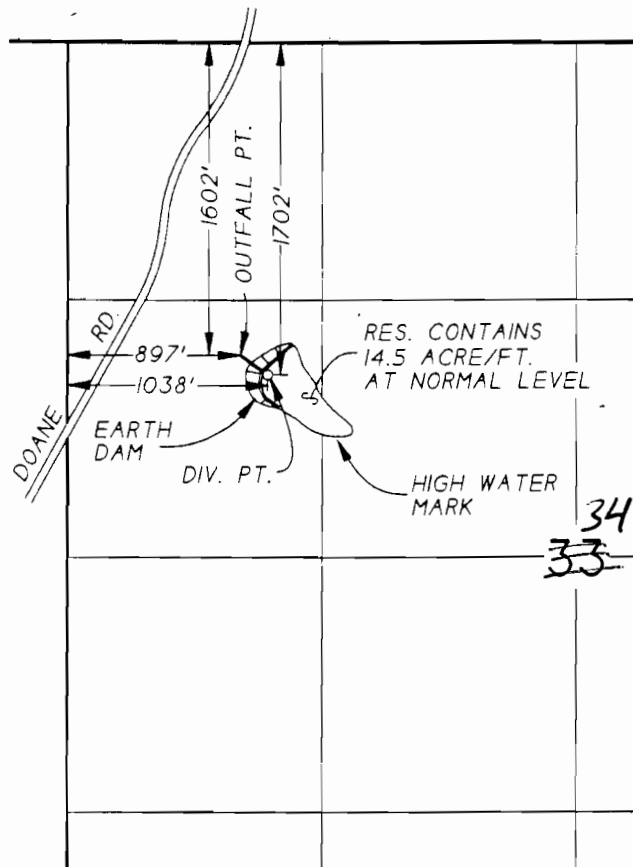

34 AC WRD
33- 7-26-2010

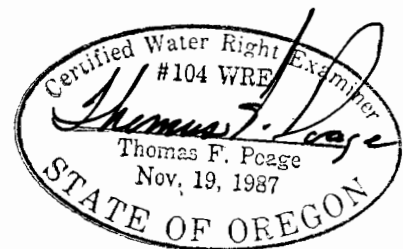

FINAL PROOF SURVEY
UNDER

APPLICATION No. R-71488, PERMIT No. R-4403

IN NAME OF

TRUTZ KRONKE

SURVEYED SEPTEMBER 16, 1995, by POAGE ENG. & SURVEYING INC.