


0516

CLAIM OF BENEFICIAL USE MAP

T2S, R3E, WM
TL 1601 AND 1700 (2 3E 28)
CLACKAMAS COUNTY, OREGON
WILLAMETTE RIVER BASIN
APPL FILE G-15506; PERMIT G-15151


PREPARED FOR:
RITA SNYDER
20930 S. HARRIS ROAD
OREGON CITY, OREGON 97045

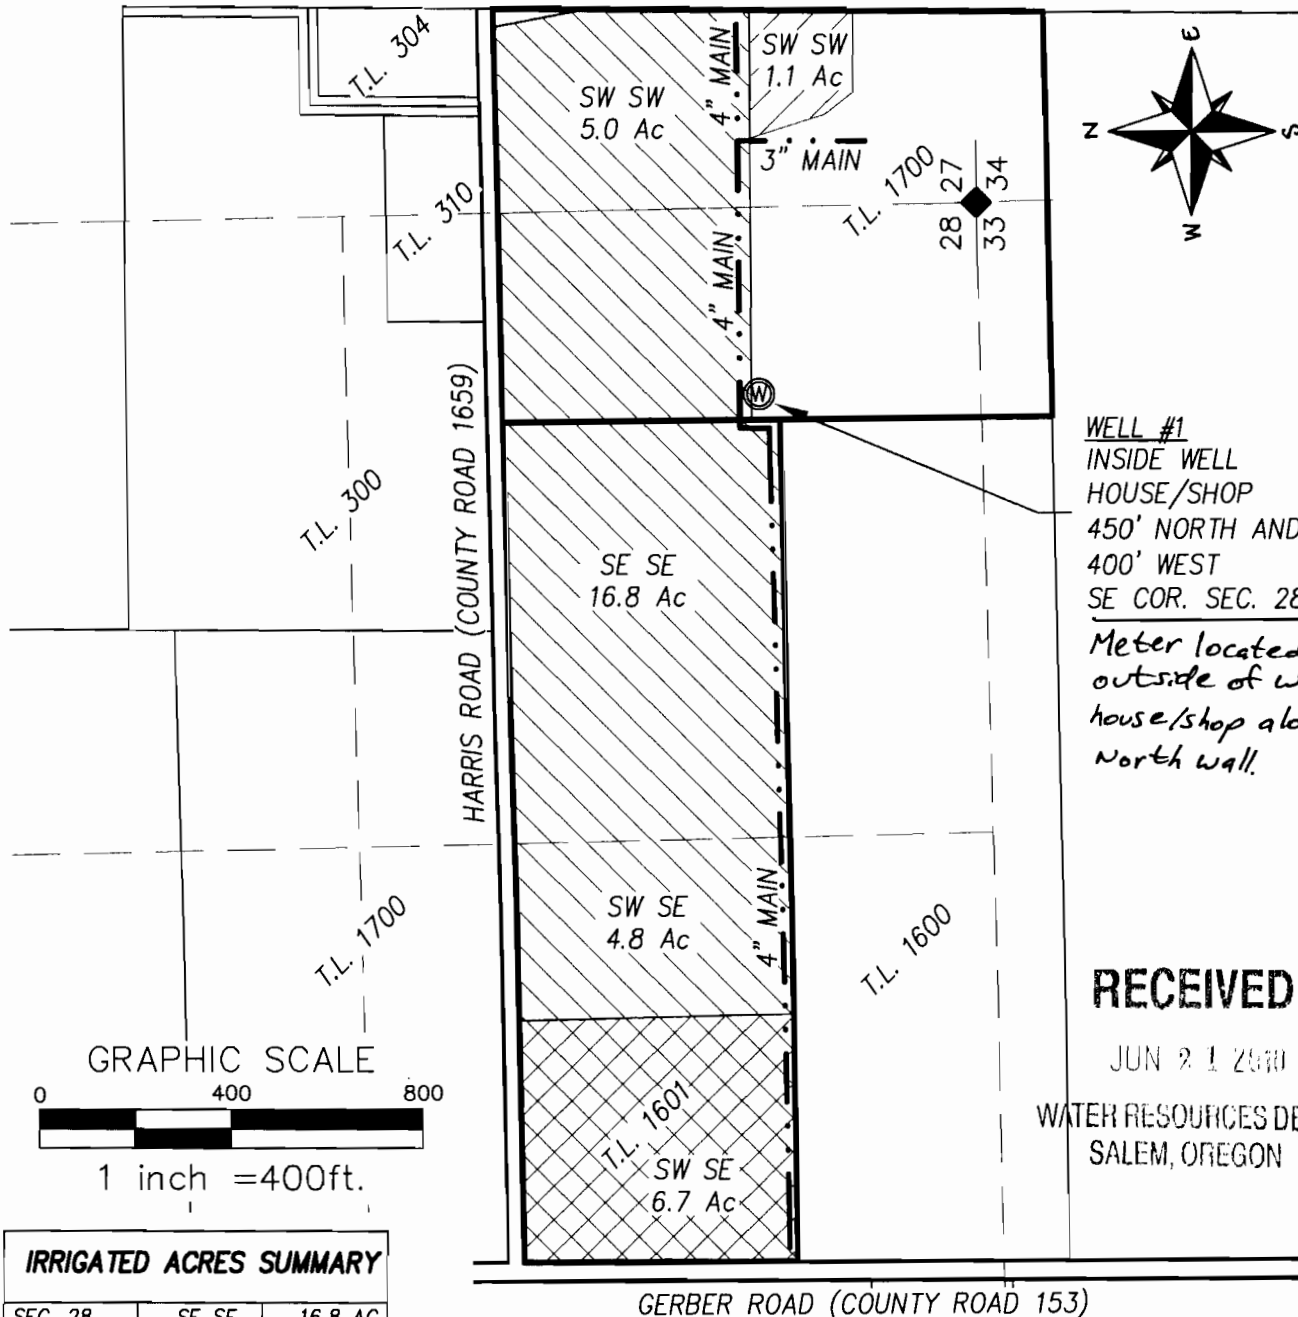

WELL #1
INSIDE WELL
HOUSE/SHOP
450' NORTH AND
400' WEST
SE COR. SEC. 28
*Meter located
outside of well
house/shop along
North wall.*

RECEIVED

JUN 21 2010
WATER RESOURCES DEPT
SALEM, OREGON

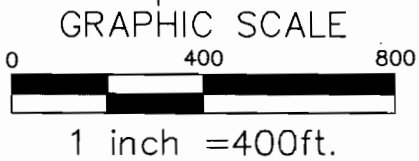

IRRIGATED ACRES SUMMARY		
SEC. 28	SE SE	16.8 AC
	SW SE	11.5 AC
	SUB- TOTAL	28.3 AC
SEC. 27	SW SW	6.1 AC
	SUB- TOTAL	6.1 AC
TOTAL IRRIGATED -		34.4 AC

- WATER WELL IS LOCATED 450' NORTH AND 400' WEST OF THE SOUTHEAST CORNER OF SECTION 28
- PERMIT G-15151 IRRIGATED AREA - CONTAINERIZED NURSERY PLANTS
- PERMIT G-15151 IRRIGATED AREAS - IN GROUND NURSERY PLANTS
- PERMIT G-15151 IRRIGATED AREAS - OTHER CROPS
- EXISTING MAIN IRRIGATION PIPES
- PROPERTY BOUNDARY LINE
- TAX LOT LINE
- 1/16TH SECTION LINE



EXPIRES : 12-31-2010
*WRD staff added meter
location. 7/12/2010 BR*



MAP BASES: CLACKAMAS COUNTY TAX MAP 2 3E 28
2006 AERIAL PHOTO

THIS MAP WAS PREPARED FOR THE PURPOSE OF IDENTIFYING THE LOCATION OF A WATER RIGHT ONLY AND IS NOT INTENDED TO PROVIDE LEGAL DIMENSIONS OR LOCATION OF PROPERTY OWNERSHIP LINES.

Project: 310-2-011
By: Kaid E. McKay
Checked by: EAU
Date: JUNE 10, 2010

COBU MAP # 0516