


Meter location added  
by WRD staff on  
July 30, 2010. BR



1" = 1320'  
T 6N, R 35E, SEC 27  
UMATILLA CO., OREGON

THIS MAP IS BASED ON USGS QUADMAP,  
ASSESSOR MAP 6N 35 274, FIELD MEASUREMENT.  
IT IS PREPARED FOR WATER RIGHT PURPOSES  
ONLY AND SHOULD NOT BE USED FOR  
PROPERTY LOCATION PURPOSES.

WATER RIGHTS  
SALEM, OREGON

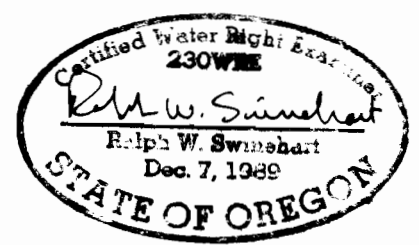

FINAL PROOF MAP  
WELL WATER RIGHT PERMIT G-13156  
FOR: FLOYD & SHARON HOOFARD  
PO BOX 757  
JOSEPH, OREGON 97874

PREPARED BY:  
WALLOWA MOUNTAIN ENGINEERING  
PO BOX 266  
ENTERPRISE, OREGON 97828  
PH: 541-424-4085

10/23/06