
RECEIVED

T.4S. R.3W. W.M.

YAMHILL COUNTY

111 17 1995

WATER RESOURCES DEPT SALEM, OREGON

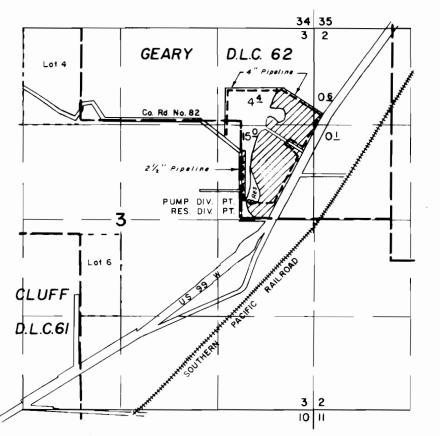

(S)

PUMP DIV. PT. 260'N & 895'W OF THE EAST 1/4 CORNER OF SEC. 3, T4S, R3W, WM RES. DIV. PT. 257'N & 850'W OF THE EAST 1/4 CORNER OF SEC. 3, T4S, R3W, WM

FINAL PROOF SURVEY

7 | 689 Application No R - 7 | 690 Permit No

51316 it No R-11409

H.E. WINTERS

July 11, 1995 SCALE: 1"= 1320

NOTE: This map is for the purpose of identifying the location of water rights and has no intent to dimension or locate property ownership lines.

Corbey Boatwright
May 30, 1989

TATE OF ORECOTA