


T. 33 S., R. 5 W., W.M.

RECEIVED

AUG 27 1999

WATER RIGHTS OFFICE
Salem, Oregon

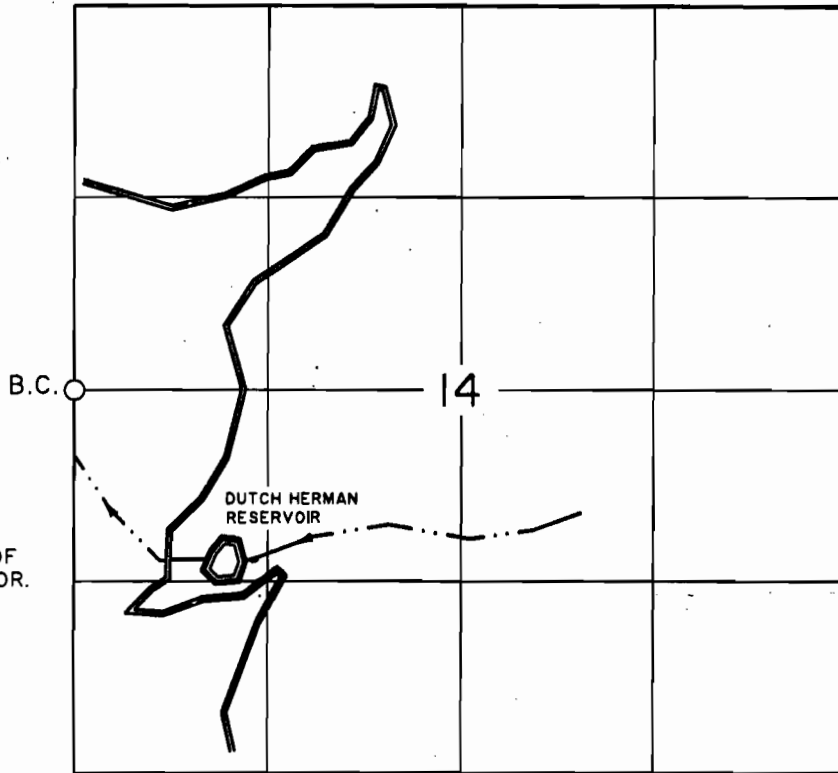

DIVERSION IS 1180 FEET SOUTH AND 900 FEET EAST OF THE W 1/4 SEC. COR. OF SECTION 14.




1" = 1320'

CLAIM OF BENEFICIAL USE MAP

IN NAME OF
UNITED STATES BUREAU OF LAND MANAGEMENT

APPLICATION NO. S-63051
R-64614

PERMIT NO. 52483
R-11870

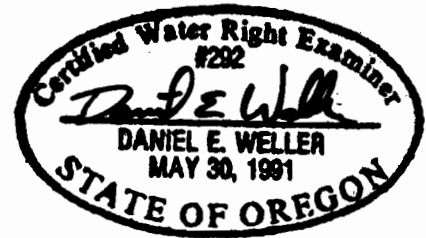

EXPIRES 6/30/00

SURVEYED: JUNE 8, 1999

THE PURPOSE OF THIS MAP IS FOR IDENTIFYING THE LOCATION OF THE WATER RIGHT ONLY AND IS NOT INTENDED TO PROVIDE LEGAL DIMENSIONS OR LOCATION OF PROPERTY OWNERSHIP LINES.

U.S. BUREAU OF LAND MANAGEMENT-OSO
BRANCH OF GEOGRAPHIC SCIENCES

DWG: BURMA

EXECUTED BY:
DANIEL E. WELLER, PLS, CWRE
P.O. BOX 2965
PORTLAND, OREGON 97208