


TAX LOT 200
 MAP 8 3W 18C
 SW 1/4 SEC.18 T8S, R3W WM, MARION COUNTY

SCALE: 1" = 100'

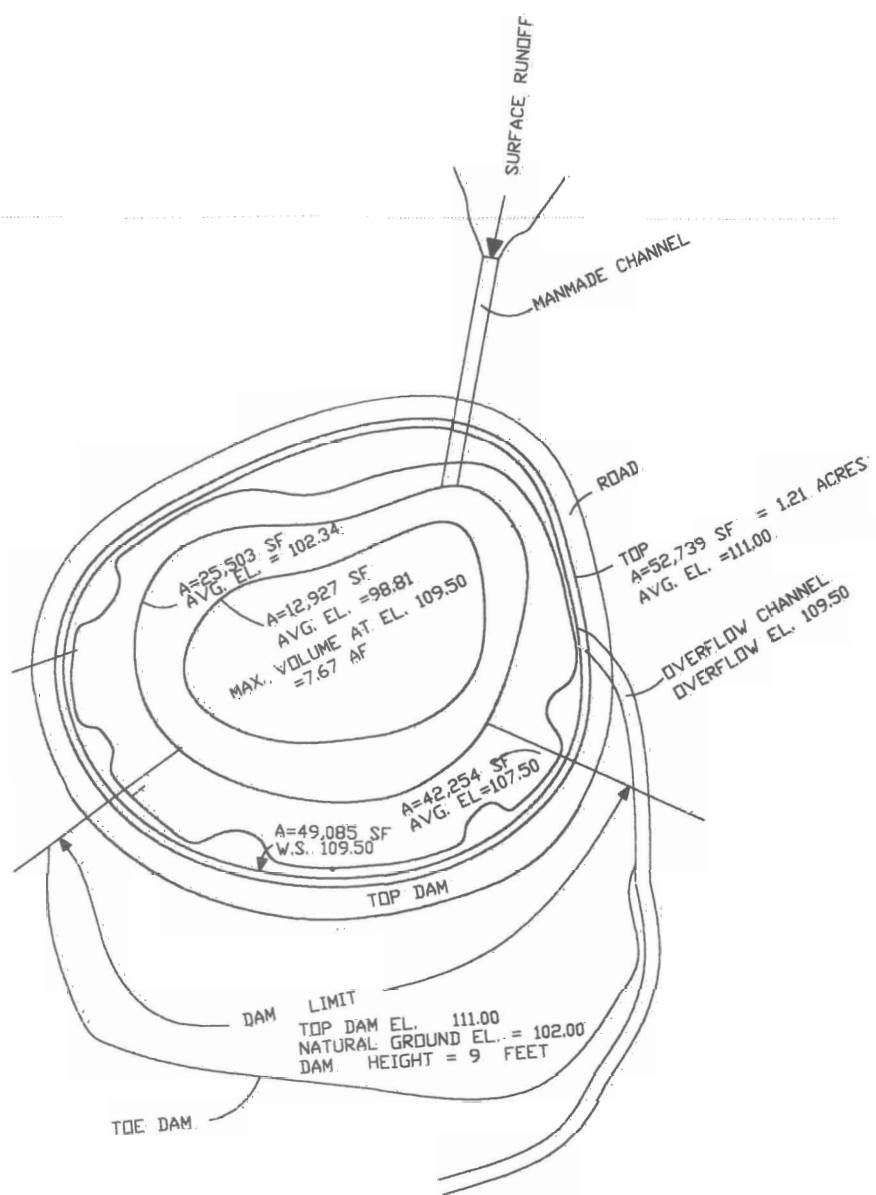

CLAIM FOR BENEFICIAL USE
 RESERVOIR AND STORAGE
 OF PUBLIC WATER
 OF PUBLIC WATER

APPLICANT: JEFF A. ZEEB
 1935 SILVERTON RD, NE
 SALEM, OREGON 97303

APR 13 2010



GoertzENGINEERING INC,
 4753 FIR DELL DRIVE SE
 SALEM, OREGON 97302
 PH. 503.378.0952
 E-mail:KDGoertz@comcast.net

DESIGNED BY: KDG
 DRAWN BY: KDG
 DATE: AUG. 2009
 REV. NO.
 SHEET