D.F.M.

31—5—6

Township 35S., Range 6W.

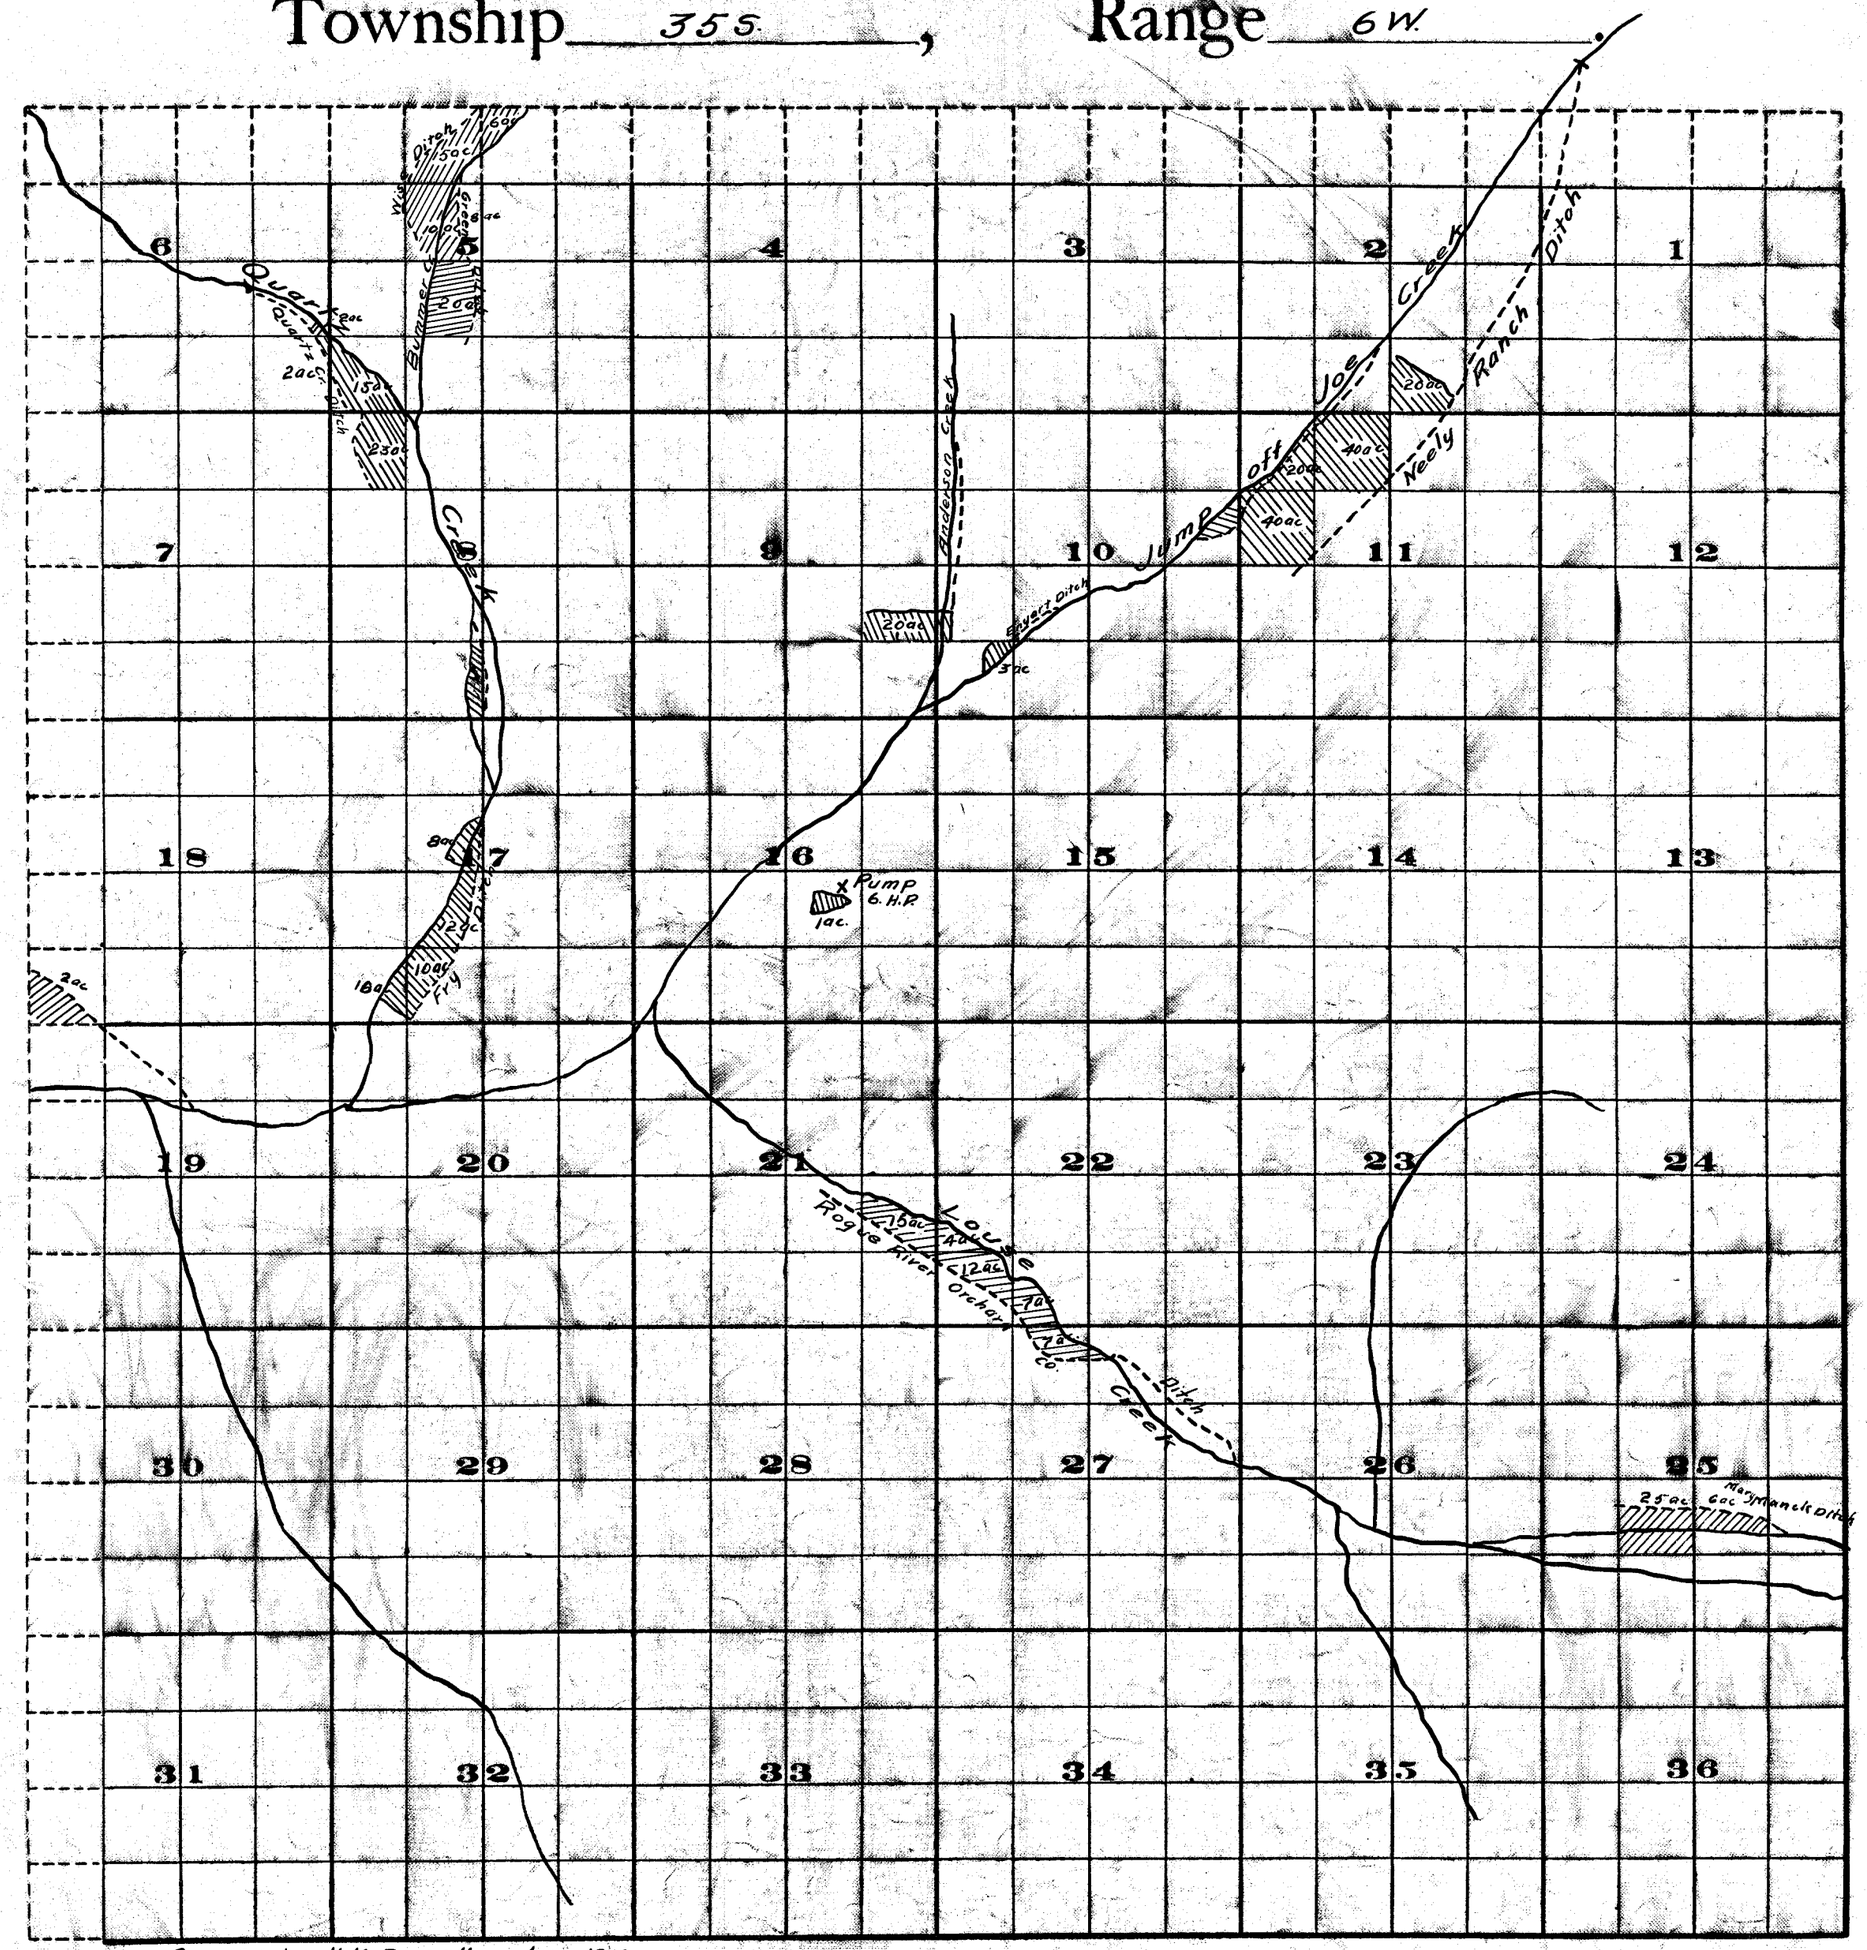

Ajudication

Rogue River and Tributaries

John H. Lewis State Eng'r.

35S. 6W.

Examined Sept. 18 1911

25